(CI)

# IREDELL COUNTY HEALTH DEPARTMENT

STATESVILLE 704-878-5305 (CI) MOORESVILLE 704-664-5281

## IMPROVEMENT PERMIT / AUTHORIZATION TO CONSTRUCT / OPERATION PERMIT / EXISTING SYSTEM INSPECTION

PERMIT# 141824 PIN# 4737893420 DATE 4-24-07

OWNER OR APPLICANT Dixieland Inc. PHONE: Business _____ Home 704 876 6162

ADDRESS Poplar Ridge #53

LOCATION Chipley Ford Rd. (R) on Bluegill, once in Poplar Ridge, 1st (L) and prop on (R)

SUBDIVISION Poplar Ridge BLOCK / SECTION 1 LOT 53 LOT AREA _____ SITE CLASS. PS DESIGN FLOW 360 L.T.A.R. .25

Septic Tank: 1000 Gallons; STB 825 Date 6-17-07

Pump Tank: 1000 Gallons; PT 702 Date 7-17-07

Pump Make: Wilson Keller Model N153 Serial No. _____

Nitrification Field: No Fields 1 Square Feet 1440 Linear Feet 360

No Lines 4 Trench Width 36" Max Trench Bottom Depth 30" Gravel Depth n/a ☐ Gravity ☒ Pressure ☐ Slab ☒ Crawl Space ☐ Basement w/plumbing ☐ Basement wo/plumbing

☒ New System ☐ Repair ☐ Expansion System Type: I II (III) IV V VI

System Description: Pump 25% Reduction

Repair System Description: LPP

Maintenance Agreement Required: ☐ Yes ☒ No

☒ House/Mod. Home No. Bedrooms 3

☐ Mobile Home No. Persons _____

☐ Business No. Employees _____


☐ Other _____

Water Supply: ☐ Individual ☒ Public ☐ Community


Comments:/Conditions:

Comments:/Conditions:

INITIAL SITE SKETCH

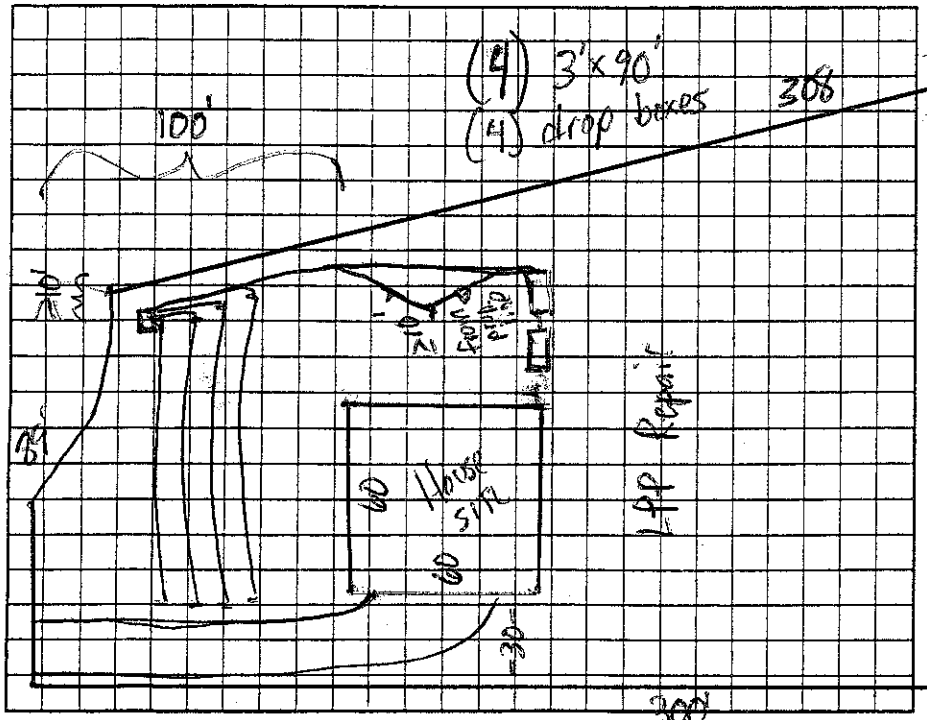


AS BUILT SKETCH

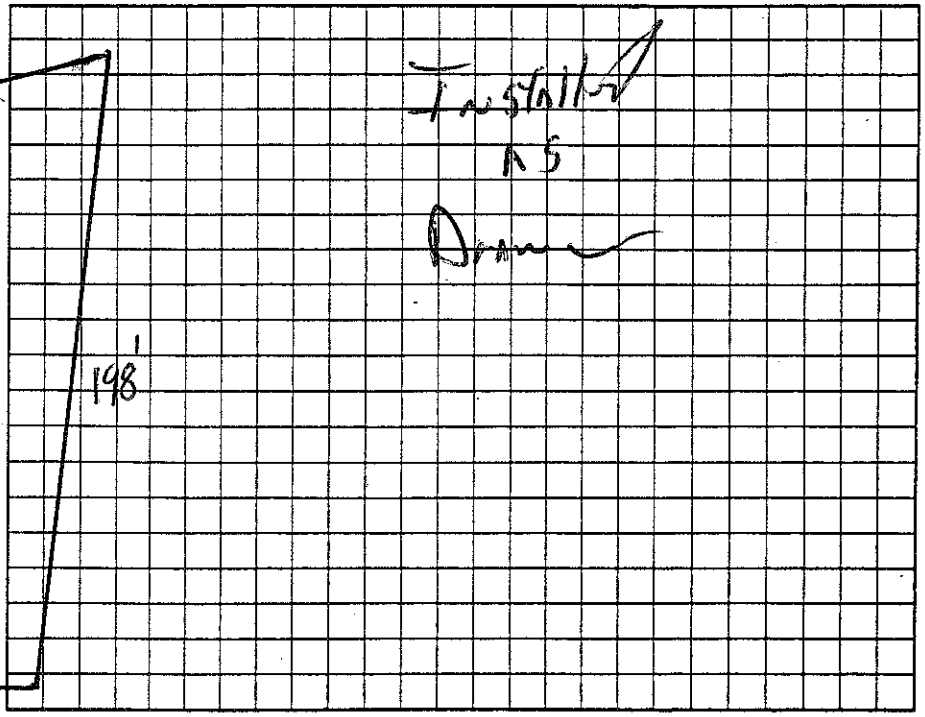


Permit can be suspended or revoked if any false information is supplied toward securing the permit/any unauthorized changes are made to the site/any unauthorized changes are made in the installation of the system. Improvement Permit with plat valid without expiration ☐ Improvement Permit with site plan valid for sixty months ☒ Authorization to Construct is valid for a period equal to that of Improvement Permit – not to exceed sixty months.

Signed: _____ date 4-25-07 Installed by: Rowan Septic

Improvement Permit by: _____ date 4-24-07 Operation Permit by: _____, R.S. date 7 Sept. 07

Authorization to Construct by: _____ date 4-24-07 Existing System Inspection by: _____ date _____

HEALTH DEPT. COPY: WHITE OWNER COPY (FINAL): YELLOW OWNER COPY (INITIAL): PINK