IREDELL COUNTY HEALTH DEPARTMENT

Statesville Office (704) 878-5305 Mooresville Office (704) 660-3625 PERMIT # 214074

IMPROVEMENT PERMIT / AUTHORIZATION TO CONSTRUCT / OPERATION PERMIT / EXISTING SYSTEM

PIN # 4737947236

APPLICANT: Kent Spears APPLICANT ADDRESS: 440 Oakhurst Rd Statesville NC

SITE ADDRESS: 398 Ingram Rd Statesville NC PHONE: 828-312-4811 ALT. PHONE: N/A

SITE DIRECTIONS: 115 N T/R Red Chimney right on Chipley Ford Pl Left on Ingram


SUBDIVISION: N/A SECTION: N/A LOT # N/A LOT AREA: 80.58 ac DESIGN FLOW: Ex L.T.A.R.: Ex

Septic Tank Ex (gal)	STB	Date	☐ New System ☐ Repair ☐ Expansion System Type: I ☒ II III IV V VI	☒ Residence	No. Bedrooms Ex	Water Supply
Pump Tank (gal)	PT	Date	System Description: Existing	☐ Business	No. Persons Ex	☒ Private
Pump Make	Model	Serial #	Repair System Description:	☐ Other	No. Employees	☐ Public
# Nitrification Fields Ex	# Lines Ex	Linear Ft: Ex	Maintenance Agreement Required: ☐ YES ☒ NO	☐ Slab	☐ Crawl Space	☐ Community
Trench Width Ex	Max. Trench Bottom Depth Ex	Gravel Depth Ex	☒ GRAVITY ☐ PRESSURE	☐ Basement w/plumbing		☒ Basement w/o plumbing

Comments / Conditions: All building foundations must be 5' from any part of STS

INITIAL SITE SKETCH

AS BUILT SKETCH

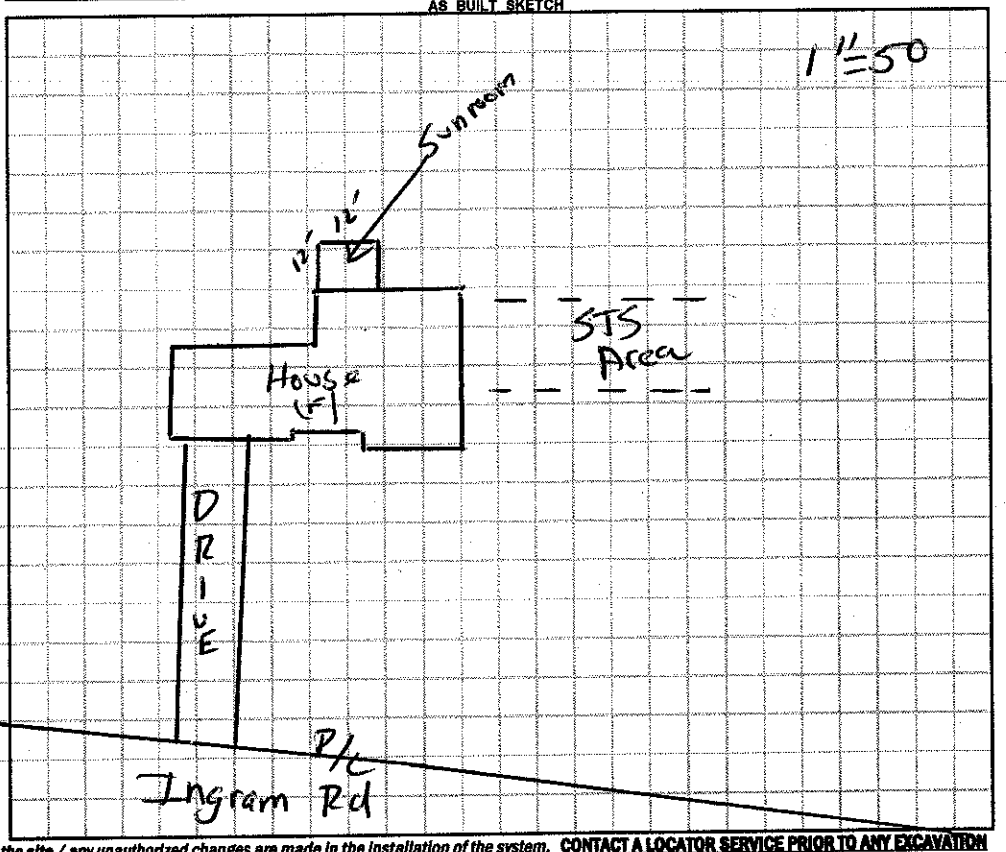

Permit can be suspended or revoked if any false information is supplied toward securing the permit / any unauthorized changes are made to the site / any unauthorized changes are made in the installation of the system. **CONTACT A LOCATOR SERVICE PRIOR TO ANY EXCAVATION**

☐ **IMPROVEMENT PERMIT** *with plat valid without expiration.* ☐ **IMPROVEMENT PERMIT** *with site plan valid for 60 mos.* ☐ **AUTHORIZATION TO CONSTRUCT** *valid for period equal to IMPROVEMENT PERMIT--not to exceed 60 mo.*

Owner / Applicant Signature: W. Kent Spears Date: 10-23-15 Installed by:

IMPROVEMENT PERMIT by: Date: OPERATION PERMIT by: Date:

AUTHORIZATION TO CONSTRUCT by: Date: Existing System Inspected by: David A Lee Date: 10/23/15

Health Dept. Copy - WHITE Applicant (Final Approval) - YELLOW Applicant (Conditional Approval) - PINK