THIS PERMIT VOIDS PREVIOUS ISSUED 12-6-99

IREDELL COUNTY HEALTH DEPARTMENT

STATESVILLE 704-878-5305 MOORESVILLE 704-664-5281

IMPROVEMENT PERMIT / AUTHORIZATION TO CONSTRUCT / OPERATION PERMIT / EXISTING SYSTEM INSPECTION

PERMIT# 086542 PIN# 4738 00 3365 (PT) DATE 2-13-01

OWNER OR CONTRACTOR CRAVEN, KEARNS, ET AL PHONE. Business (704) 872-6645 Home

ADDRESS 374 LONG ISLAND ROAD, STATESVILLE NC 28677

LOCATION NC 115 N, TR BRANCHWOOD, TL RIVERFIELD, TR GRASSY MEADOW, LOT HALFWAY ON RIGHT

SUBDIVISION RIDGECREST BLOCK / SECTION III LOT 72 LOT AREA 0.7163 ACRES SITE CLASS PS DESIGN FLOW 360 L.T.A.R. 0.30 GPD/FT²

Septic Tank: 1000 Gallons; STB 1012 Date 1-7-01
Pump Tank: 1000 Gallons; PT 17 Date 8-14-00
Pump Make: HYDROMATIC Model SHEF50A1 Serial No.
Nitrification Field: No Fields 1 Square Feet 1200 Linear Feet 400
No Lines FOUR Trench Width 36" Max Trench Bottom Depth 36" Gravel Depth 12"

☒ New System ☐ Repair System Type: I II III IV V VI
System Description: CONVENTIONAL PUMP
Repair System Description: 50% REDUCTION PUMP
Maintenance Agreement Required: ☐ Yes ☐ No

☐ House/Mod. Home ☒ Mobile Home ☐ Business ☐ Other
No. Bedrooms 3 No. Bathrooms 2 No. Employees


Water Supply: ☐ Individual ☒ Public ☐ Community

☐ Slab ☒ Crawl Space ☐ Basement w/plumbing ☐ Basement wo/plumbing


Comments:/Conditions: SEE ATTACHED SHEETS FOR PUMP AND PRESSURE MANIFOLD REQUIREMENTS

Comments /Conditions: ① SEPTIC TANK WITH MARKER INSTALLED USING "POLY LOK" FILTER ② SYSTEM PRESSURE CHECKED 3-26-01

INITIAL SITE SKETCH SCALE: 1"=40'

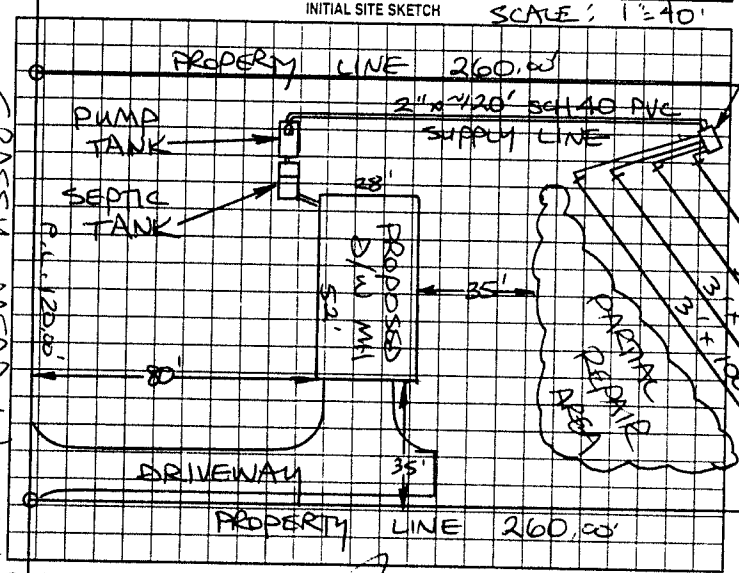

AS BUILT SKETCH

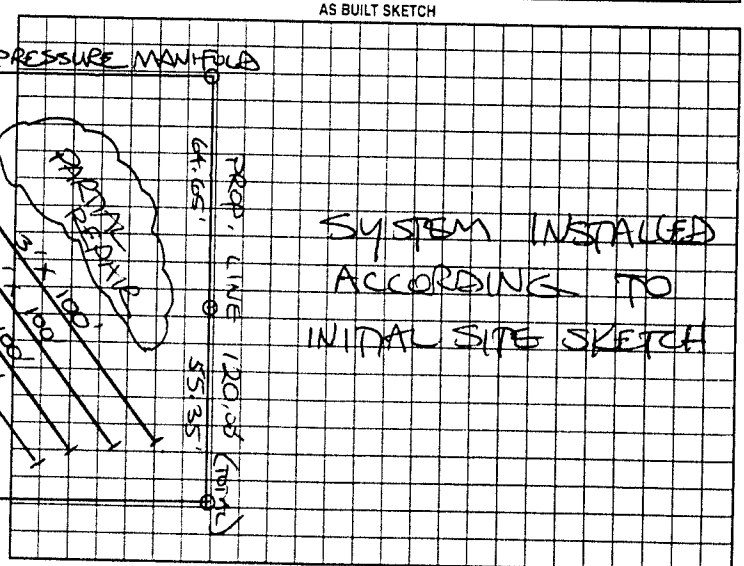

GRASSY MEADOW LANE

Permit can be suspended or revoked if any false information is supplied toward securing the permit/any unauthorized changes are made to the site/any unauthorized changes are made in the installation of the system. Improvement Permit with plat valid without expiration. Improvement Permit with site plan valid for sixty months. Authorization to Construct is valid for a period equal to that of Improvement Permit – not to exceed sixty months.

Signed: _____ date _____

Improvement Permit by: STEVE HEDRICK date 2-13-01

Authorization to Construct by: STEVE HEDRICK date 2-13-01

Installed by: A-1 BACKHOE

Operation Permit by: STEVE HEDRICK date 4-5-01

Existing System Inspection by: _____ date _____

HEALTH DEPT COPY WHITE OWNER COPY (FINAL) YELLOW OWNER COPY (INITIAL) PINK