IREDELL COUNTY HEALTH DEPARTMENT

STATESVILLE 704-878-5305 MOORESVILLE 704-664-5281

IMPROVEMENT PERMIT / CERTIFICATE OF COMPLETION / OPERATION PERMIT / EXISTING SYSTEM INSPECTION

PROPERTY DESCRIPTION NO. 25995 94075 DATE 5-17-97 TAX MAP NO. 4738 00 6849 Watershed: ~~WS-IV~~ PA ☐ ~~WS-I~~ ☐ ~~WS-II~~ ☐ ~~WS-III~~ ☐ No

OWNER OR CONTRACTOR CRAVEN, KEARNS, McDOWELL PHONE: Business (910) 672-2269 Home

ADDRESS P.O. BOX 2257, ASHEBORO, NC 27204

LOCATION NC 115 N, TR BRANCHWOOD ROAD, 5TH LOT ON LEFT PAST HANGING TREE LANE

SUBDIVISION RIDGECREST BLOCK / SECTION I LOT 22 LOT AREA 0.847 ACRE SITE CLASS. PS DESIGN FLOW 360 L.T.A.R. 0.30 gpd/ft²

Septic Tank: 1000 Gallons; STB 794 Date 2-13-00
Pump Tank: _____ Gallons; PT _____ Date _____
Pump Make: _____ Model _____ Serial No. _____
Nitrification Field: No Fields 1 Square Feet 1200 Linear Feet 400
No Lines FOUR Trench Width 36" Max Trench Bottom Depth 36" Gravel Depth 12"

☑ New System ☐ Repair System Type: I (II) III, IV, V, VI
System Description: CONV. GRAVITY
Repair System Description: CONV. GRAVITY
Maintenance Agreement Required: ☐ Yes ☑ No

☐ ~~House/Mod. Home~~ ☑ Mobile Home ☐ Business ☐ Other
No. Bedrooms 3 No. Bathrooms 2 No. Employees ____


☐ Slab ☑ Crawl Space ☐ Basement w/plumbing ☐ Basement wo/plumbing

Water Supply: ☐ Individual ☐ Community ☑ Public


Comments:

Comments:
- Poly Lok Filter Installed
- Septic Tank marker Installed

INITIAL SITE SKETCH SCALE: 1"=50'

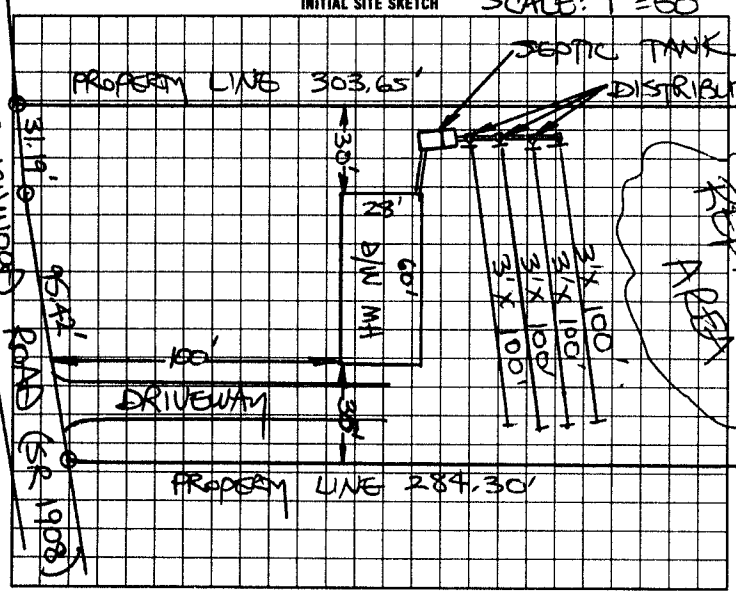

AS BUILT SKETCH

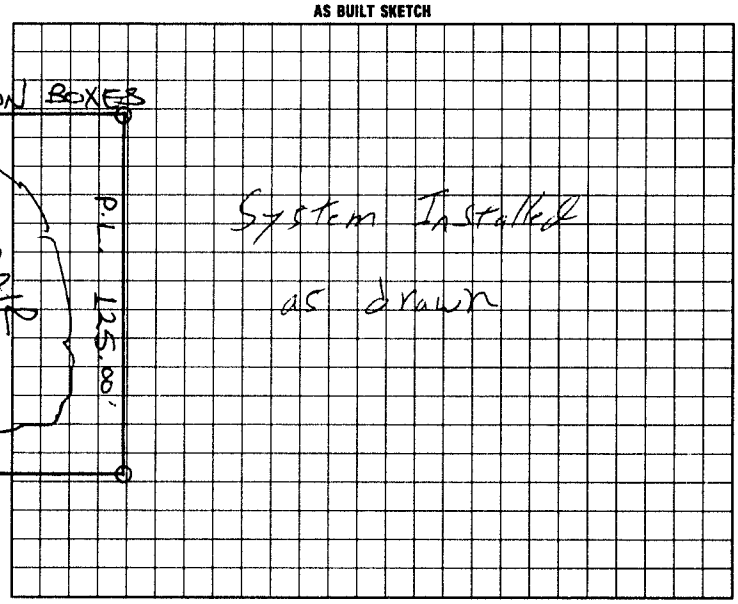

I understand that this permit can be suspended or revoked if any false information is supplied toward securing the permit/any unauthorized changes are made to the site/any unauthorized changes are made in the installation of the system. Improvement Permit is valid for 60 months from date of issuance. AUTHORIZATION TO CONSTRUCT IS VALID FOR 60 MONTHS FROM DATE OF ISSUANCE.

Signed: _____

Improvement Permit by: STEVE HEDRICK date 5-17-97

Existing System Inspection by: STEVE HEDRICK date 5-17-97

Installed by: Craig Thompson

~~Certificate of Completion by:~~ _____ date _____

Operation Permit by: William Johnson RSI date 06-11-01

HEALTH DEPT. COPY: WHITE INSPECTION COPY (FINAL): GREEN OWNER COPY (FINAL): YELLOW INSPECTION COPY (INITIAL): PINK OWNER COPY (INITIAL): GOLD