IREDELL COUNTY HEALTH DEPARTMENT

Const. Auth. STATESVILLE 704-878-5305 MOORESVILLE 704-664-5281

IMPROVEMENT PERMIT / ~~CERTIFICATE OF COMPLETION~~ / OPERATION PERMIT / EXISTING SYSTEM INSPECTION

PROPERTY DESCRIPTION NO. 25998 DATE July 1, '97 TAX MAP NO. 4738 00 6849 Watershed: ☑ Yes ☐ No

OWNER OR CONTRACTOR Phil Craven PHONE: Business Home (910) 672-2269 WSIIPA

ADDRESS 1534 Lake Country Dr, Asheboro, N.C. 27203

LOCATION 115 N from Statesville TR Branchwood Rd ~1-1½ miles on left

SUBDIVISION Ridgecrest BLOCK / SECTION LOT 25 LOT AREA .777 Ac SITE CLASS. PS DESIGN FLOW 360 gpd L.T.A.R. .3

Septic Tank: 1000 Gallons; STB 821 Date 11-17-97

Pump Tank: Gallons; PT Date

Pump Make: Model Serial No.

Nitrification Field: No Fields 1 Square Feet 1200 Linear Feet 400

No Lines 4@100 Trench Width 36" Max Trench Bottom Depth 24" Gravel Depth 12"

☑ New System ☐ Repair System Type: I, II, III, IV, V, VI

System Description: gravity conventional

Repair System Description: gravity conventional

Maintenance Agreement Required: ☐ Yes ☑ No

☐ House/Mod. Home ☑ Mobile Home DW ☐ Business ☐ Other

No. Bedrooms 3 No. Bathrooms 2 No. Employees


☐ Slab ☑ Crawl Space ☐ Basement w/plumbing ☐ Basement wo/plumbing

Water Supply: ☐ Individual ☐ Community ☑ Public


Comments: Septic installer note trench bottom depth Top of septic tank to be set at grade/gravel - Backfill to provide cover desired.

Comments:

INITIAL SITE SKETCH

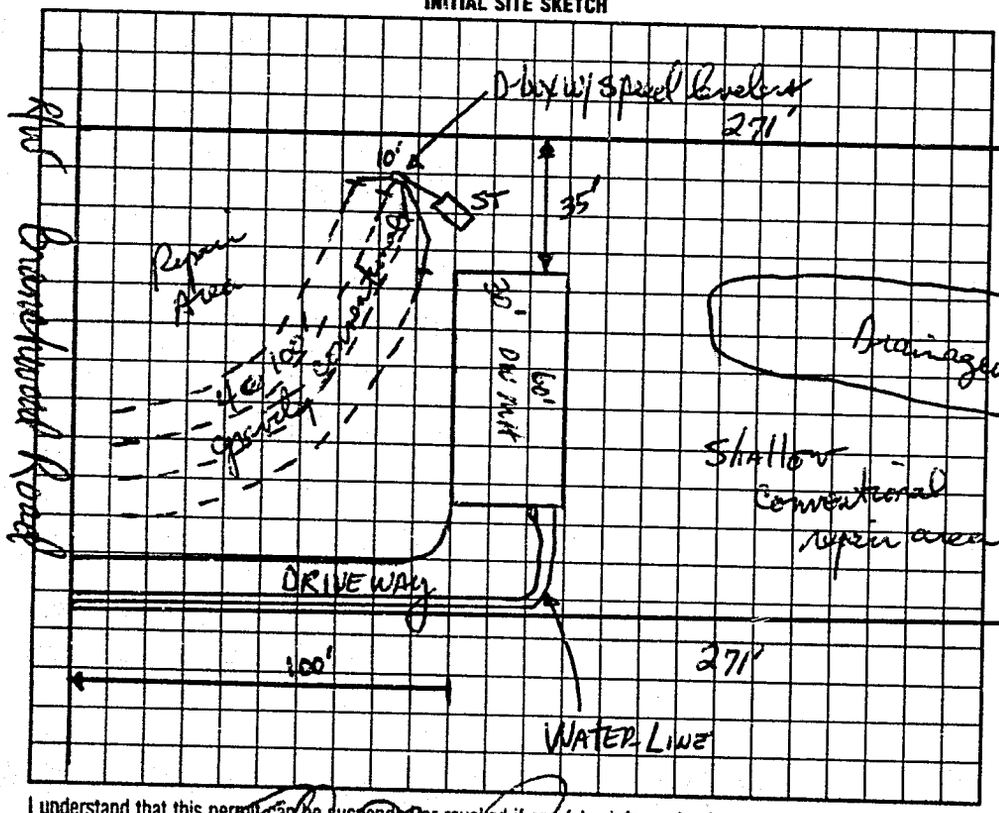

AS BUILT SKETCH

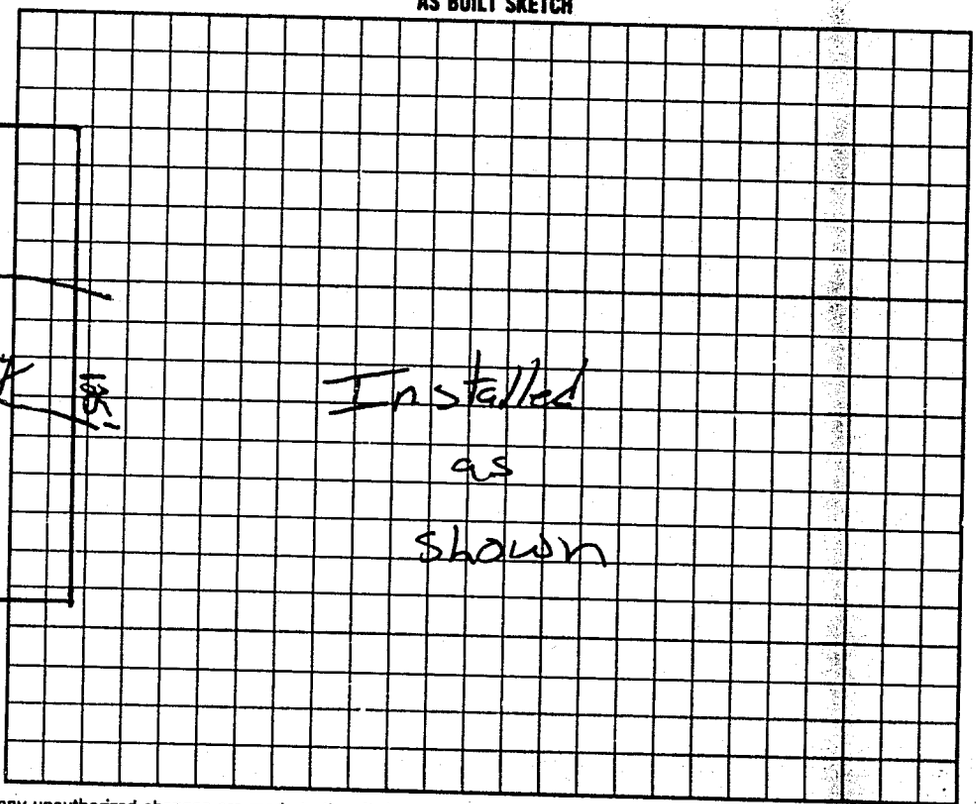

I understand that this permit can be suspended or revoked if any false information is supplied toward securing the permit/any unauthorized changes are made to the site/any unauthorized changes are made in the installation of the system. Improvement Permit is valid for 60 months from date of issuance.

Signed:

Improvement Permit by: RS date 7-1-97

~~Existing System Inspection by:~~ CONSTRUCTION AUTHORIZATION RS date 7-1-97

Installed by: G+M Enterprises

Certificate of Completion by: date

Operation Permit by: RS date 1-26-98

HEALTH DEPT. COPY: WHITE INSPECTION COPY (FINAL): GREEN OWNER COPY (FINAL): YELLOW INSPECTION COPY (INITIAL): PINK OWNER COPY (INITIAL): GOLD