IREDELL COUNTY HEALTH DEPARTMENT

STATESVILLE 704-878-5305 MOORESVILLE 704-664-5281

IMPROVEMENT PERMIT / AUTHORIZATION TO CONSTRUCT / OPERATION PERMIT / EXISTING SYSTEM INSPECTION

PERMIT# 075736 PIN# 4738 01 4179 (PART) DATE 10-14-98

OWNER OR CONTRACTOR CRAVEN & OTHERS PHONE: Business (910) 672-2269 Home

ADDRESS P.O. BOX 2257, ASHEBORO, NC 27204

LOCATION NC 115 N, TR BRANCHWOOD, TL RIVERFIELD, TR MOUNTAIN CREST, AT END ON RIGHT

SUBDIVISION RIDGECREST BLOCK / SECTION II LOT 1091 LOT AREA 5.012 ACRES SITE CLASS. PS DESIGN FLOW 360 L.T.A.R. @.30 GPD/FT²

Septic Tank: 1000 Gallons; STB 1012 Date 9-12-98

Pump Tank: Gallons; PT Date

Pump Make: Model Serial No.

Nitrification Field: No Fields 1 Square Feet 1200 Linear Feet 400

No Lines FIVE Trench Width 36" Max Trench Bottom Depth 36" Gravel Depth 12"

☑ New System ☐ Repair System Type: I, II, III, IV, V, VI

System Description: CONVENTIONAL GRAVITY

Repair System Description: CONV. GRAVITY

Maintenance Agreement Required: ☐ Yes ☑ No

☐ House/Mod. Home No. Bedrooms 3

☑ Mobile Home No. Bathrooms 2

☐ Business No. Employees

☐ Other


☐ Slab ☑ Crawl Space ☐ Basement w/plumbing ☐ Basement wo/plumbing

Water Supply: ☐ Individual ☑ Public ☐ Community


Comments:/Conditions:

Comments:/Conditions: SYSTEM INSTALLED ACCORDING TO INITIAL SITE SKETCH

INITIAL SITE SKETCH

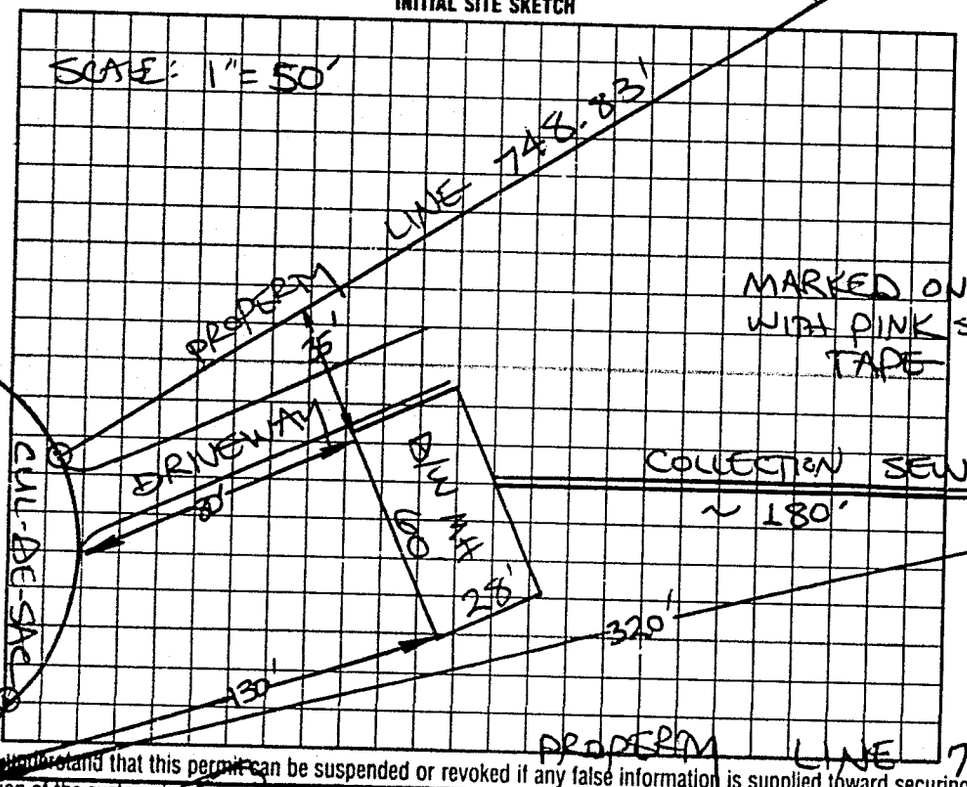

AS BUILT SKETCH

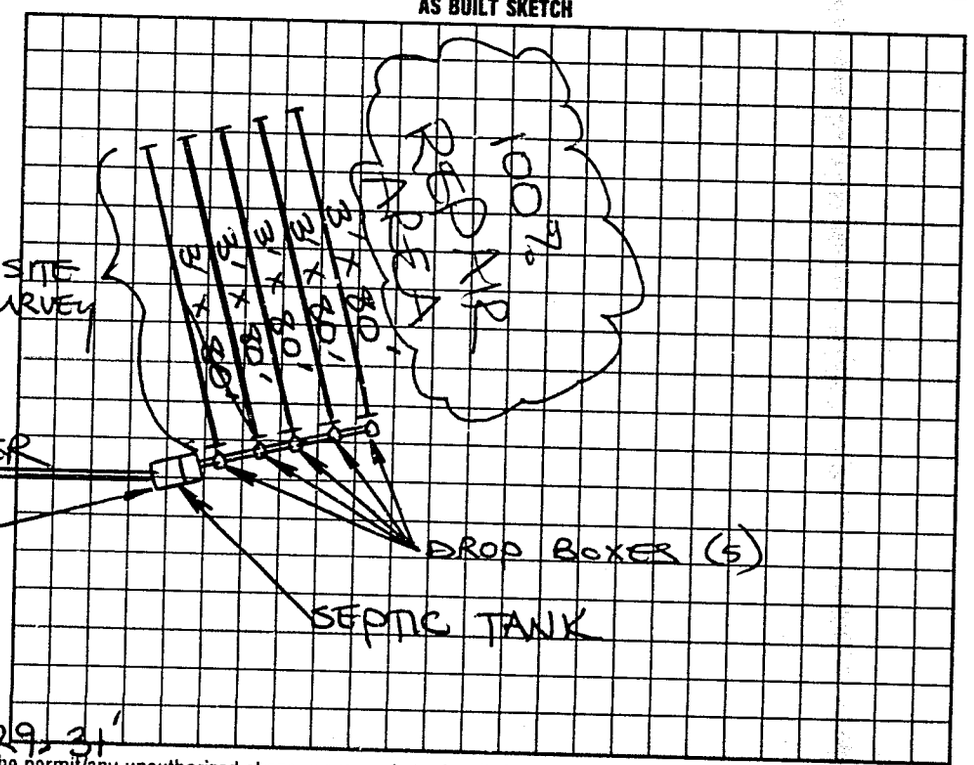

I understand that this permit can be suspended or revoked if any false information is supplied toward securing the permit/any unauthorized changes are made to the site/any unauthorized changes are made in the installation of the system. Improvement Permit with plat valid without expiration. Improvement Permit with site plan valid for sixty months. Authorization to Construct is valid for a period equal to that of Improvement Permit – not to exceed sixty months.

Signed: date

Improvement Permit by: STEVE HEDRICK date 10-14-98

Authorization to Construct by: STEVE HEDRICK date 10 14-98

Installed by: TOMMY FRYE

Operation Permit by: STEVE HEDRICK date 11-13-98

Existing System Inspection by date

HEALTH DEPT. COPY: WHITE INSPECTION COPY (FINAL): GREEN OWNER COPY (FINAL): YELLOW INSPECTION COPY (INITIAL): PINK OWNER COPY (INITIAL): GOLD