IREDELL COUNTY HEALTH DEPARTMENT

STATESVILLE 704-878-5305 MOORESVILLE 704-664-5281

IMPROVEMENT PERMIT / AUTHORIZATION TO CONSTRUCT / OPERATION PERMIT / EXISTING SYSTEM INSPECTION

PERMIT# 079477 PIN# 4738 01 5286 DATE 3-17-99

OWNER OR CONTRACTOR CRAVEN ET AL PHONE: Business 872-6645 Home

ADDRESS P.O. Box 2257 ASHEBORO NC 27204

LOCATION NC 115 N, TR BRANCHWOOD, TL FOREST GROVE, TL GRASSY MEADOW, TR BEAVERWOOD, 3RD ON LEFT

SUBDIVISION RIDGECREST BLOCK / SECTION II LOT 122 LOT AREA 0.999 Acre SITE CLASS PS DESIGN FLOW 360 L.T.A.R. 0.30 GPD/FT2

Septic Tank: 1000 Gallons; STB 1012 Date 1-10-99 — ✓ New System | Repair System Type: I, II, III, IV, V, VI — House/Mod. Home | ✓ Mobile Home | Business | Other — No. Bedrooms 3 — No. Bathrooms 2 — No. Employees — Water Supply: ☐ Individual ☑ Public ☐ Community

Pump Tank: 1000 Gallons; PT 17 Date 11-30-98 — System Description: 2012 HORIZONTAL HDS pump — Repair System Description: LOW PRESSURE PIPE


Pump Make: Hydromatic Model SKE50M1 Serial No. 5T867808-7 — Maintenance Agreement Required: Yes ✓ No

Nitrification Field: No Fields Square Feet Linear Feet — No Lines FIVE Trench Width 36" Max Trench Bottom Depth 20" Depth 12" HDS — Slab ✓ Crawl Space | Basement w/plumbing | Basement wo/plumbing


Comments/Conditions: ① INSTALL THIRTY (30) HDS SECTIONS IN FIVE EQUAL LENGTH LINES USING 2012 HORIZONTAL CONFIGURATION ② SEE ATTACHED SHEETS FOR PUMP & PRESSURE MANIFOLD REQUIREMENTS

Comments/Conditions: 3-25 Checked Lines & tank PUMP INADEQUATE 5-6-99, PUMP TANK RISER TO BE EXTENDED 5-6-99 ELECTRICAL & ALARM CHECK OK - RSH

INITIAL SITE SKETCH SCALE: 1" = 50'

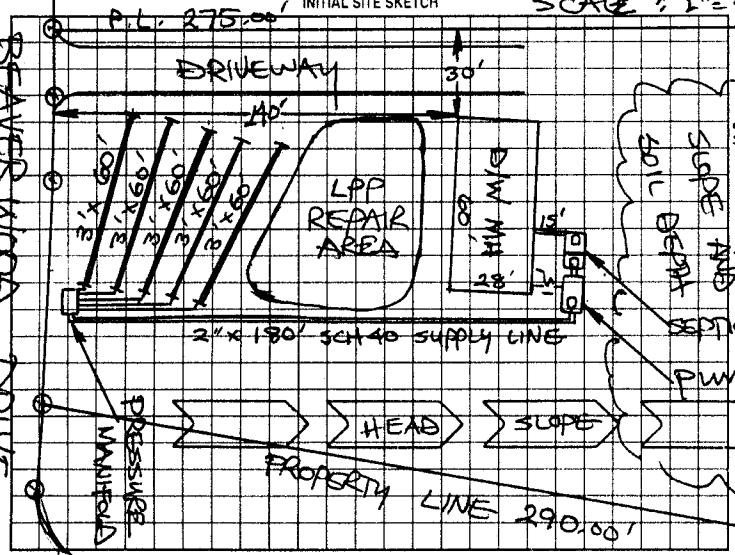

AS BUILT SKETCH

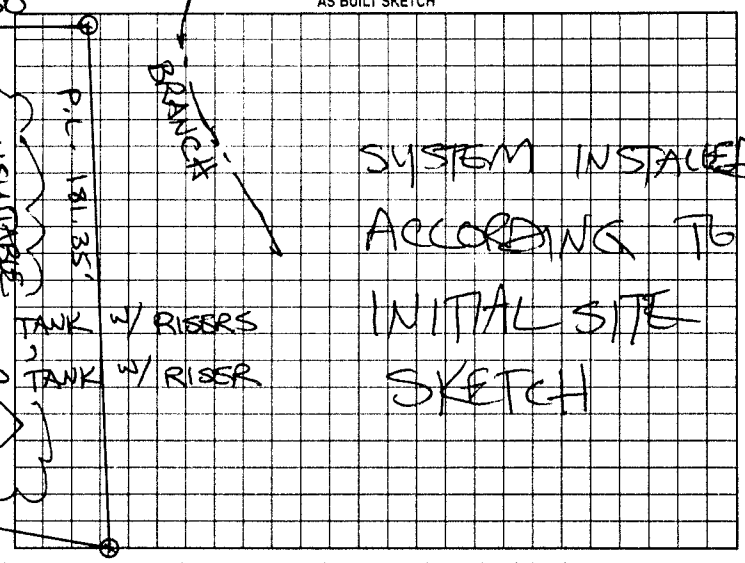

Permit can be suspended or revoked if any false information is supplied toward securing the permit/any unauthorized changes are made to the site/any unauthorized changes are made in the installation of the system. Improvement Permit with plat valid without expiration. Improvement Permit with site plan valid for sixty months. Authorization to Construct is valid for a period equal to that of Improvement Permit – not to exceed sixty months.

Signed: [signature] date 3-17-99 Installed by: A-1 BACK HOE

Improvement Permit by: STEVE HEDRICK date 3-17-99 Operation Permit by: STEVE HEDRICK date 5-10-99

Authorization to Construct by: STEVE HEDRICK date 3-17-99 Existing System Inspection by: date

HEALTH DEPT COPY WHITE OWNER COPY (FINAL) YELLOW OWNER COPY (INITIAL) PINK

CHC-BE-SAC