IREDELL COUNTY HEALTH DEPARTMENT

STATESVILLE 704-878-5305 MOORESVILLE 704-664-5281

IMPROVEMENT PERMIT / AUTHORIZATION TO CONSTRUCT / OPERATION PERMIT / EXISTING SYSTEM INSPECTION

PERMIT# 080605 PIN# 4738 01 9056

OWNER OR CONTRACTOR CRAVEN & OTHERS PHONE: Business 872-6695 Home DATE 4-26-99

ADDRESS 374 LONG ISLAND ROAD STATESVILLE NC 28677

LOCATION NC 115 N TR BRANCHWOOD RD, TL FOREST GROVE, TL GRASSY MEADOW, 3RD LOT ON RIGHT

SUBDIVISION RIDGECREST BLOCK / SECTION II LOT 41 LOT AREA 0.901 ACRE SITE CLASS PS DESIGN FLOW 360 L.T.A.R. 0.25 GPD/FT2

Septic Tank: 1000 Gallons; STB 1012 Date 7-24-99
Pump Tank: ____ Gallons; PT ____ Date ____
Pump Make: ____ Model ____ Serial No ____
Nitrification Field: No Fields 1 Square Feet ETO 1440 Linear Feet 360
No Lines THREE Trench Width 36" Max Trench Bottom Depth 30" Min Trench Depth 12"

☑ New System ☐ Repair System Type: I, II, III, IV, V
System Description: 2012 HORIZONTAL H.D.S.
Repair System Description: 2012 HORIZONTAL H.D.S.
Maintenance Agreement Required: ☐ Yes ☑ No


☐ House/Mod. Home ☑ Mobile Home ☐ Business ☐ Other
No. Bedrooms 3 No. Bathrooms 2 No. Employees ____
☐ Slab ☐ Crawl Space ☐ Basement w/plumbing ☐ Basement wo/plumbing

Water Supply: ☐ Individual ☑ Public ☐ Community


Comments:/Conditions: INSTALL THIRTY-SIX (36) H.D.S. SECTIONS ON CONTOUR AS FLAGGED NO DEEPER THAN 30 INCHES.

Comments/Conditions SEPTIC TANK WITH MARKER INSTALLED USING "POLY LOK" FILTER

INITIAL SITE SKETCH

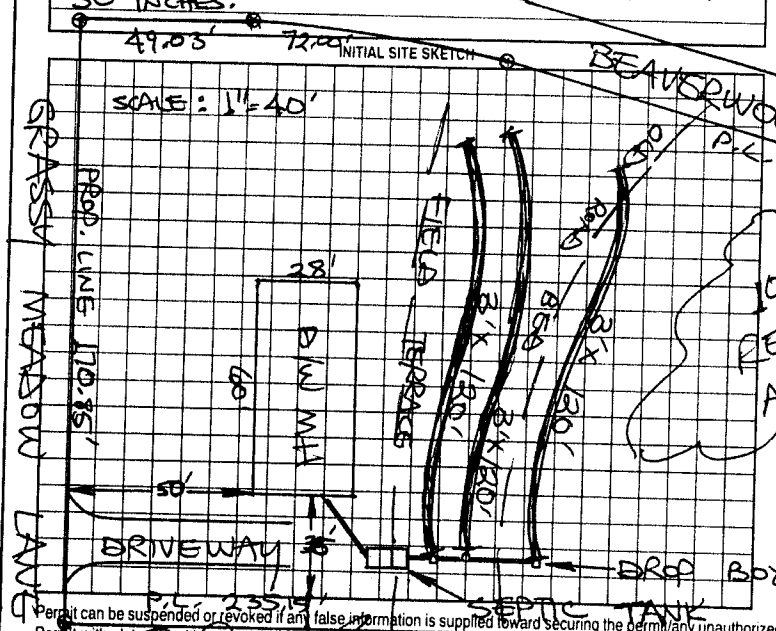

AS BUILT SKETCH

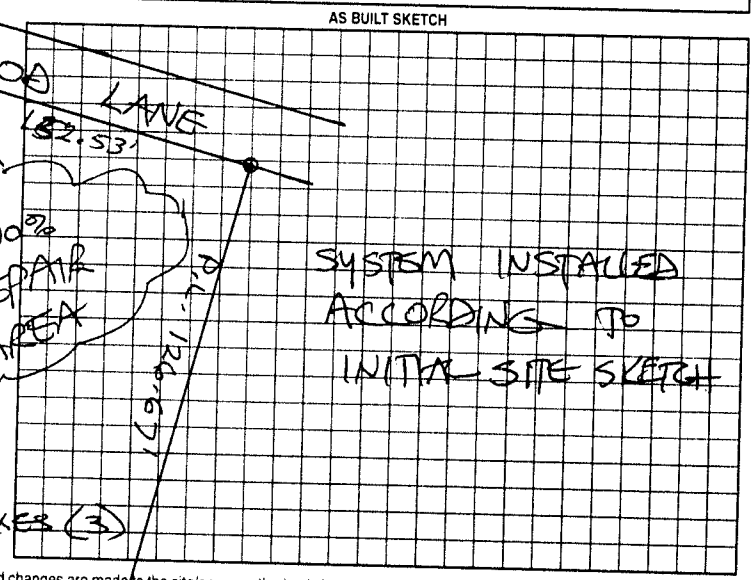

Permit can be suspended or revoked if any false information is supplied toward securing the permit/any unauthorized changes are made to the site/any unauthorized changes are made in the installation of the system. Improvement Permit with plat valid without expiration. Improvement Permit with site plan valid for sixty months. Authorization to Construct is valid for a period equal to that of Improvement Permit – not to exceed sixty months.

Signed: ____ date ____

Improvement Permit by: STEVE HEDRICK date 4-26-99

Authorization to Construct by: STEVE HEDRICK date 4-26-99

Installed by: A-1 BACKHOE

Operation Permit by: STEVE HEDRICK date 10-8-99

Existing System Inspection by: ____ date ____

HEALTH DEPT COPY WHITE OWNER COPY (FINAL) YELLOW OWNER COPY (INITIAL) PINK