79268

IREDELL COUNTY HEALTH DEPARTMENT Const. Auth.

STATESVILLE 704-878-5305 MOORESVILLE 704-664-5281

IMPROVEMENT PERMIT / ~~CERTIFICATE OF COMPLETION~~ / OPERATION PERMIT / EXISTING SYSTEM INSPECTION

PROPERTY DESCRIPTION NO. 25999 DATE July 1, '97 TAX MAP NO. 4738 00 6849 (pt) Watershed: ☑ Yes ☐ No

OWNER OR CONTRACTOR Phil Cropsey PHONE: Business Home (910) 672-2269 WS III PA

ADDRESS 534 Lake Crowders Dr. Statesville NC 28625

LOCATION 115 N from Statesville TR Branchwood Rd; 1-1½ miles on left

SUBDIVISION Ridgecrest BLOCK / SECTION LOT 26 LOT AREA .78 Ac SITE CLASS. PS DESIGN FLOW 360 gpd L.T.A.R. ~.3

Septic Tank: 1000 Gallons; STB 1012 Date 9-19-98

Pump Tank: Gallons; PT Date

Pump Make: Model Serial No.

Nitrification Field: No Fields 1 Square Feet 1200 Linear Feet 400

No Lines 5@80 Trench Width 36" Max Trench Bottom Depth 24" Gravel Depth 12"

☑ New System ☐ Repair System Type: I, II, III, IV, V, VI

System Description: gravity conventional

Repair System Description: grav/pump/conventional

Maintenance Agreement Required: ☐ Yes ☑ No

☐ House/Mod. Home No. Bedrooms 3

☑ Mobile Home DW No. Bathrooms 2

☐ Business No. Employees

☐ Other


☐ Slab ☑ Crawl Space ☐ Basement w/plumbing ☐ Basement wo/plumbing

Water Supply: ☐ Individual ☐ Community ☑ Public


Comments: Septic installer note trench bottom depth.

Comments: SYSTEM CHANGE APPROVED 11-30-98

INITIAL SITE SKETCH

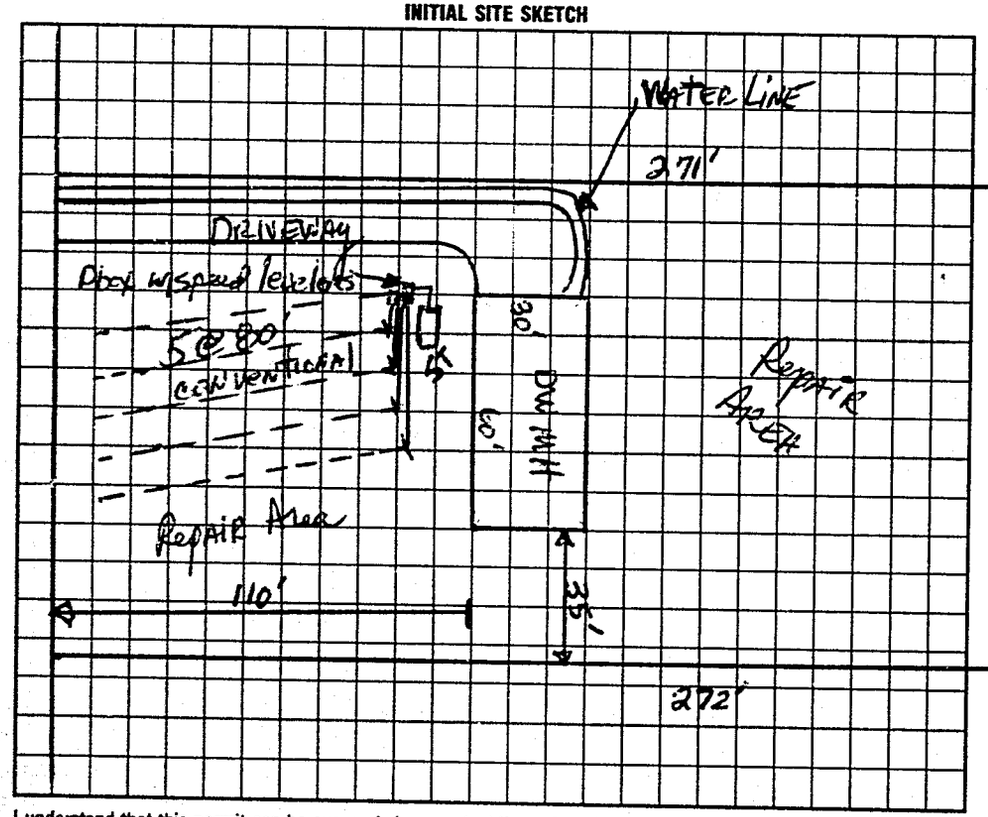

AS BUILT SKETCH

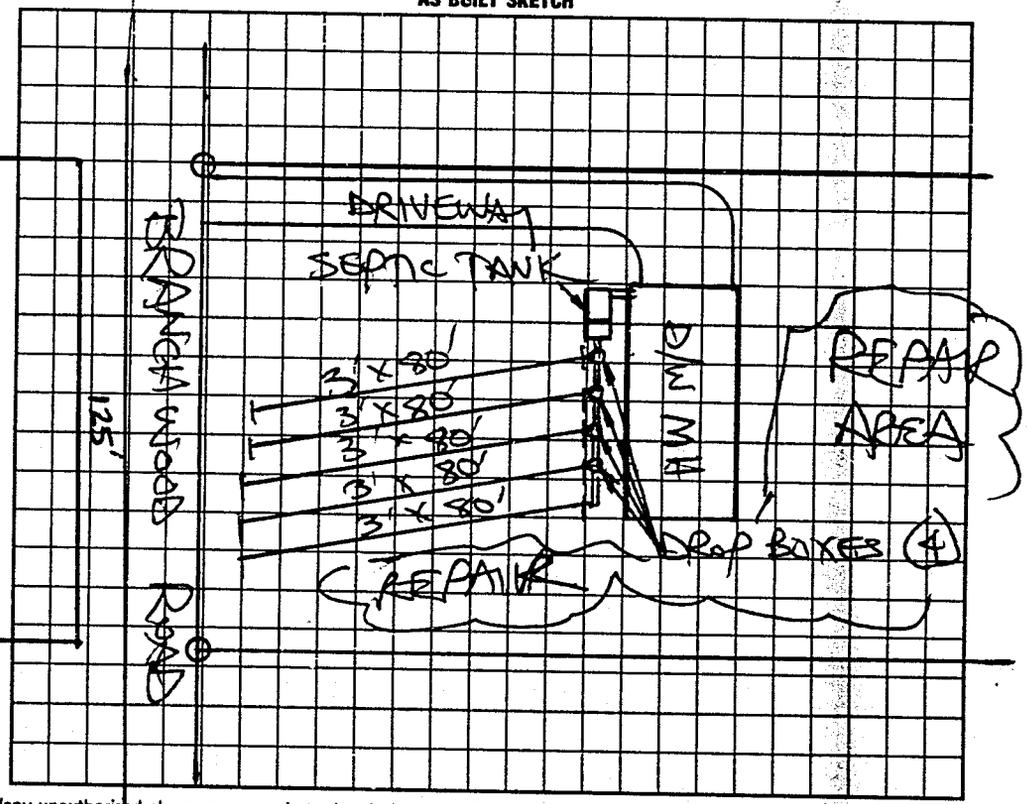

I understand that this permit can be suspended or revoked if any false information is supplied toward securing the permit/any unauthorized changes are made to the site/any unauthorized changes are made in the installation of the system. Improvement Permit is valid for 60 months from date of issuance.

Signed:

Improvement Permit by: DHuffman, REHS date 7-1-97

~~Existing System Inspection By:~~ DHuffman, REHS date 7-1-97

Installed by: A-1 BACKHOE

Certificate of Completion by: STEVE HEDRICK date 12-1-98

Operation Permit by: date

HEALTH DEPT. COPY: WHITE INSPECTION COPY (FINAL): GREEN OWNER COPY (FINAL): YELLOW INSPECTION COPY (INITIAL): PINK OWNER COPY (INITIAL): GOLD