THIS PERMIT REPLACES PREVIOUS ISSUED 8-25-04

IREDELL COUNTY HEALTH DEPARTMENT

STATESVILLE 704-878-5305 (C1) MOORESVILLE 704-664-5281

IMPROVEMENT PERMIT / AUTHORIZATION TO CONSTRUCT / OPERATION PERMIT / EXISTING SYSTEM INSPECTION

PERMIT# 12151 PIN# 4738-10-1468 DATE 11-19-04

OWNER OR CONTRACTOR RAY BENGE PHONE: Business 704-838-1429 Home

ADDRESS 590 MOCKSVILLE HIGHWAY STATESVILLE NC 28625

LOCATION NC 115 NORTH, TR BRANCHWOOD ROAD, 1.3 MILES ON LEFT

SUBDIVISION RIDGEWEST BLOCK / SECTION I LOT 27 LOT AREA 0.782 ACRE SITE CLASS. PS DESIGN FLOW 360 L.T.A.R. 0.30 GPD/FT²

Septic Tank: 1000 Gallons; STB 1012 Date 11-21-04
Pump Tank: Gallons; PT Date
Pump Make: Model Serial No.
Nitrification Field: No Fields Square Feet 1200 Linear Feet 300
No Lines FIVE Trench Width 36" Max Trench Bottom Depth 24" Gravel Depth N/A

☑ New System ☐ Repair System Type: I, II, III, IV, V, VI
System Description: 25% REDUCTION, GRAVITY
Repair System Description: 50% REDUCTION, LOW PRESSURE
Maintenance Agreement Required: ☐ Yes ☑ No ☐ Other
☐ Slab ☑ Crawl Space ☐ Basement w/plumbing ☐ Basement wo/plumbing


☑ House/Mod. Home No. Bedrooms 3
☐ Mobile Home No. Bathrooms
☐ Business No. Employees

Water Supply: ☐ Individual ☑ Public ☐ Community


Comments/Conditions: INSTALL 25% REDUCTION SYSTEM ON CONTOUR AS FLAGGED, NO DEEPER THAN 24"

Comments/Conditions: SEPTIC TANK WITH MARKER INSTALLED ~~ACCESS~~ USING "TUFFITE" FILTER

INITIAL SITE SKETCH

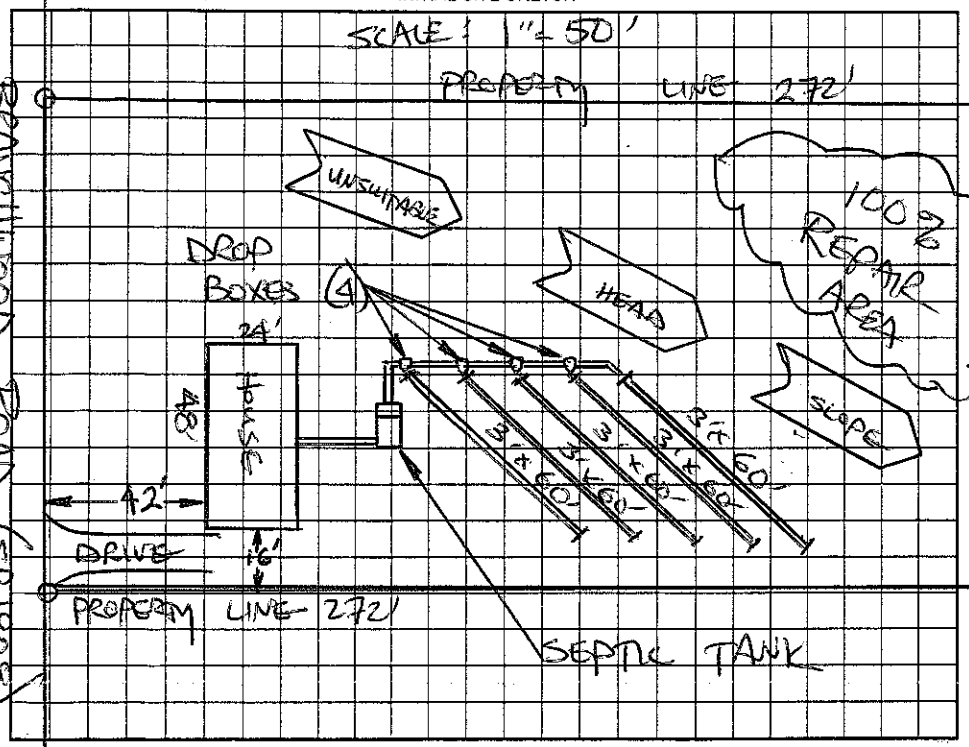

AS BUILT SKETCH

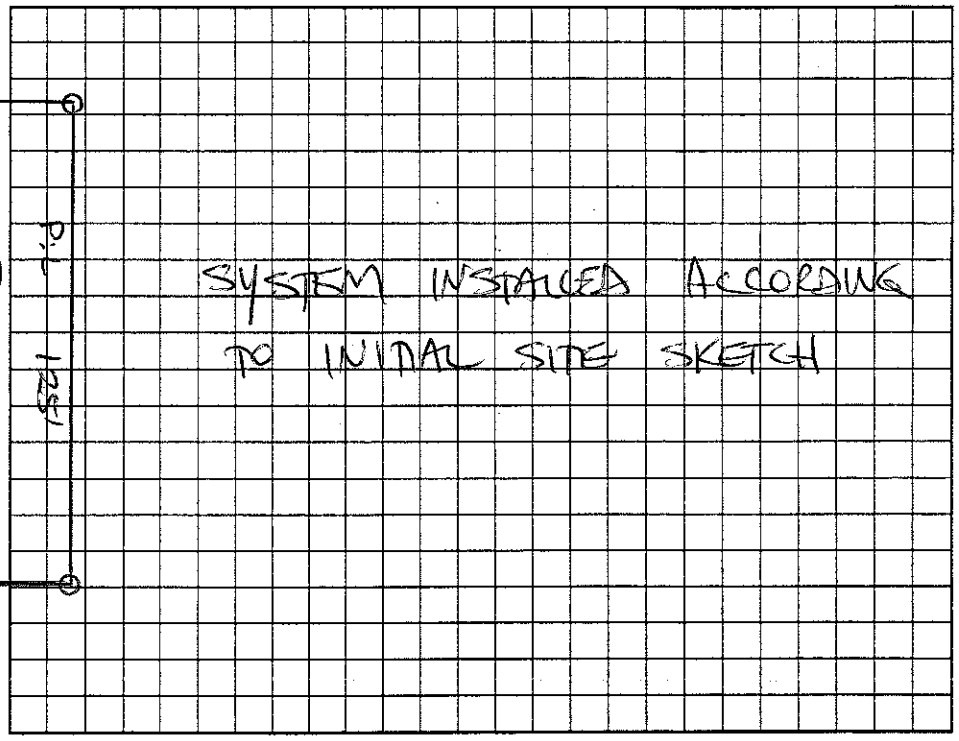

Permit can be suspended or revoked if any false information is supplied toward securing the permit/any unauthorized changes are made to the site/any unauthorized changes are made in the installation of the system. Improvement Permit with plat valid without expiration. Improvement Permit with site plan valid for sixty months. Authorization to Construct is valid for a period equal to that of Improvement Permit – not to exceed sixty months.

Signed: Michael Benge date 11-23-04 Installed by: C & S GRADING

Improvement Permit by: STEVE HEDRICK date 11-19-04 Operation Permit by: STEVE HEDRICK date 1-27-05

Authorization to Construct by: STEVE HEDRICK date 11-19-04 Existing System Inspection by: date

HEALTH DEPT. COPY: WHITE OWNER COPY (FINAL): YELLOW OWNER COPY (INITIAL): PINK