IREDELL COUNTY HEALTH DEPARTMENT

Const. Auth STATESVILLE 704-878-5305 MOORESVILLE 704-664-5281

IMPROVEMENT PERMIT / ~~CERTIFICATE OF COMPLETION~~ / OPERATION PERMIT / EXISTING SYSTEM INSPECTION

PROPERTY DESCRIPTION NO. 2690-01-0769.39 DATE July 1, '97 TAX MAP NO. 4738 00 6849 (pt.)

OWNER OR CONTRACTOR Phil Craven PHONE: Business _____ Home _____ Watershed: ☑ Yes ☐ No

ADDRESS 1534 Lake Country Dr., Asheboro, N.C. 27203 WS II PA

LOCATION 115 N. from Statesville TR Branchwood Rd. ~ 1-1½ miles on left

SUBDIVISION Ridgecrest BLOCK / SECTION _____ LOT 28 LOT AREA ± .782 Ac SITE CLASS PS DESIGN FLOW 360 gpd L.T.A.R. ~.3

Septic Tank: 1000 Gallons; STB 1012 Date 6-29-98

Pump Tank: _____ Gallons; PT _____ Date _____

Pump Make: _____ Model _____ Serial No. _____

Nitrification Field: No Fields 1 Square Feet 1200 Linear Feet 400

No Lines 4 @ 100 Trench Width 36" Max Trench Bottom Depth 24" Gravel Depth 12"

☑ New System ☐ Repair System Type: I, II, III, IV, V, VI

System Description: gravity conventional

Repair System Description: gravel pumped conventional

Maintenance Agreement Required: ☐ Yes ☑ No

☐ House/Mod. Home ☑ Mobile Home DW ☐ Business ☐ Other

No. Bedrooms 3 No. Bathrooms 2 No. Employees _____


☐ Slab ☑ Crawl Space ☐ Basement w/plumbing ☐ Basement wo/plumbing

Water Supply: ☐ Individual ☐ Community ☑ Public


Comments: Septic installer note trench bottom depth

Comments: Driveway switched to opposite side

INITIAL SITE SKETCH

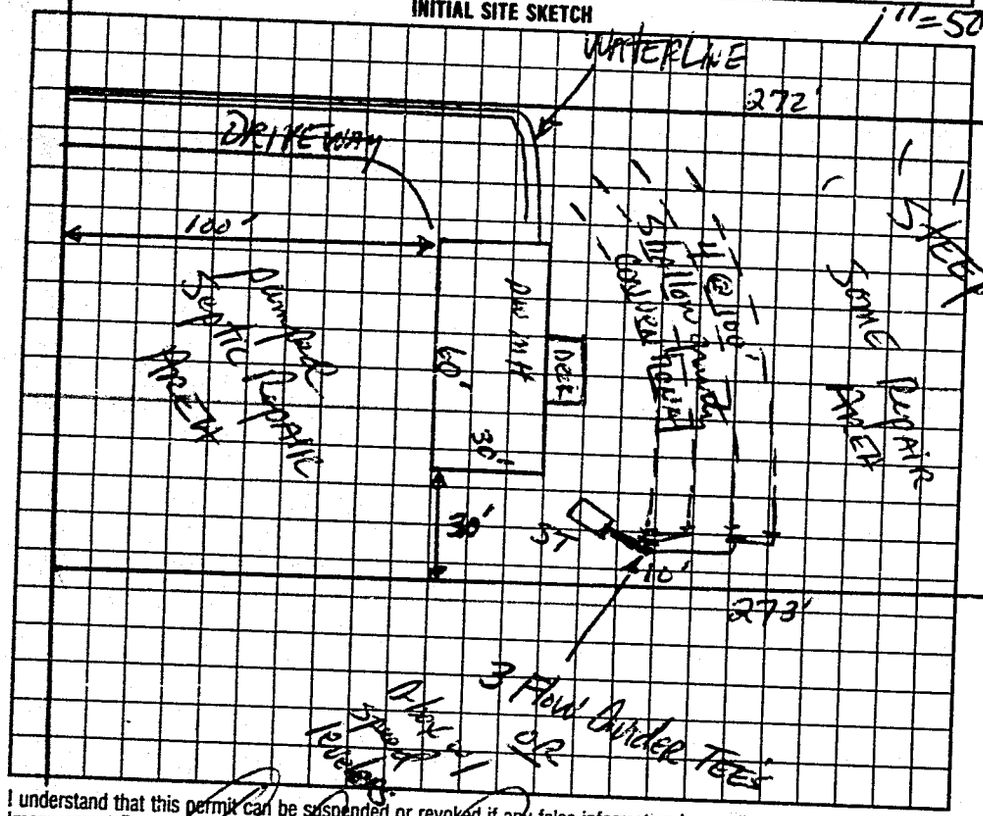

AS BUILT SKETCH

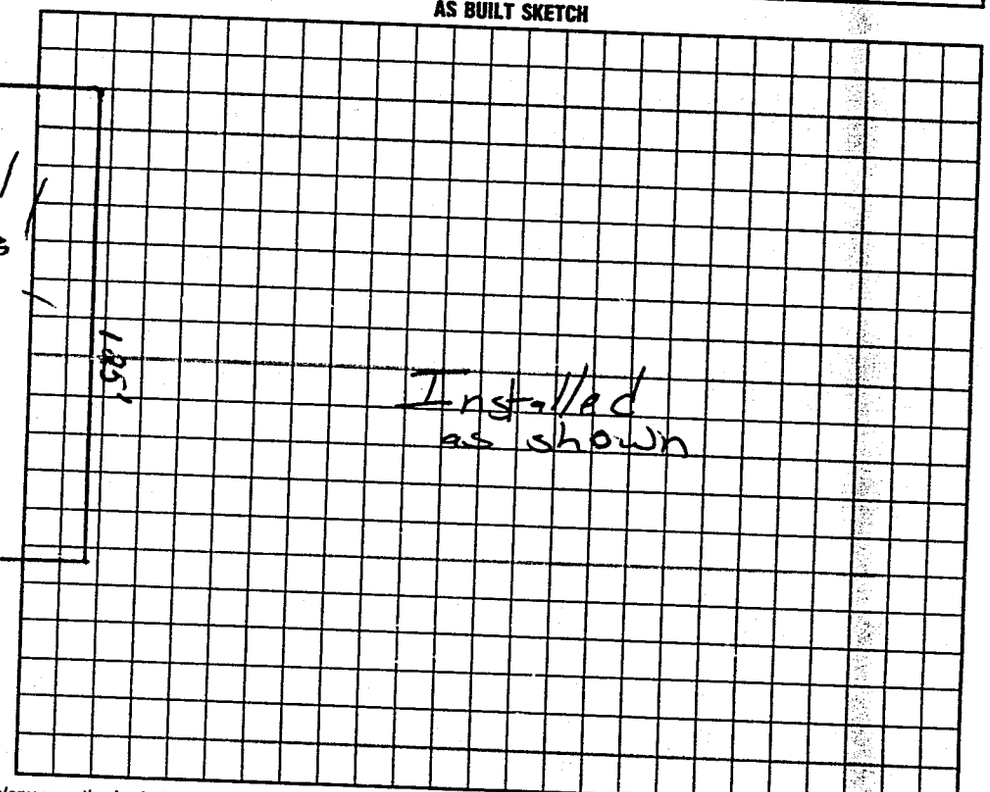

I understand that this permit can be suspended or revoked if any false information is supplied toward securing the permit/any unauthorized changes are made to the site/any unauthorized changes are made in the installation of the system. Improvement Permit is valid for 60 months from date of issuance.

Signed: _____

Improvement Permit by: D. Johnson, RS date 7-1-97

~~Existing System Inspection by:~~ D. Johnson, RS date 7-1-97

Installed by: A-1 Backhoe

~~Certificate of Completion by:~~ _____ date _____

Operation Permit by _____ date _____

HEALTH DEPT. COPY: WHITE INSPECTION COPY (FINAL): GREEN OWNER COPY (FINAL): YELLOW INSPECTION COPY (INITIAL): PINK OWNER COPY (INITIAL): GOLD