THIS PERMIT VOIDS PREVIOUS ISSUED 4.26.99

IREDELL COUNTY HEALTH DEPARTMENT

STATESVILLE 704-878-5305 MOORESVILLE 704-664-5281

IMPROVEMENT PERMIT / AUTHORIZATION TO CONSTRUCT / OPERATION PERMIT / EXISTING SYSTEM INSPECTION

PERMIT# 080606 PIN# 4738 10 2942 DATE 3-24-00

OWNER OR CONTRACTOR CRAVEN & OTHERS PHONE: Business 872-6645 Home

ADDRESS 374 LONG ISLAND ROAD, STATESVILLE, NC 28677

LOCATION NC 115 N, TR BRANCHWOOD ROAD, TL FORREST GROVE ROAD, TL GRASSY MEADOW LANE, 2ND LOT ON LEFT

SUBDIVISION RIDGECREST BLOCK / SECTION II LOT 80 LOT AREA 0.755 ACRES SITE CLASS PS DESIGN FLOW 480' L.T.A.R. 0.33 GPD/FT²

Septic Tank: 1000 Gallons; STB 1012 Date 12-15-99
Pump Tank: ____ Gallons; PT ____ Date ____
Pump Make: ____ Model ____ Serial No. ____
Nitrification Field: No Fields 1 Square Feet EQ. TO 1440 Linear Feet 360+
No Lines SIX Trench Width 36" Max Trench Bottom Depth 36" Depth SAND 6"

☑ New System ☐ Repair System Type: I, II, (III), IV, V, VI
System Description: 25% REDUCTION, GRAVITY
Repair System Description 25% REDUCTION, PUMP
Maintenance Agreement Required: ☐ Yes ☑ No

☐ House/Mod. Home ☑ Mobile Home ☐ Business ☐ Other
No. Bedrooms 4 No. Bathrooms 2 No. Employees ____

☐ Slab ☑ Crawl Space ☐ Basement w/plumbing ☐ Basement wo/plumbing


Water Supply: ☐ Individual ☑ Public ☐ Community

Comments/Conditions: INSTALL 25% REDUCTION SYSTEM USING SIXTY (60) CHAMBERS OR THIRTY-SIX (36) HDS SECTIONS


Comments/Conditions

SCALE: 1"=40'

INITIAL SITE SKETCH

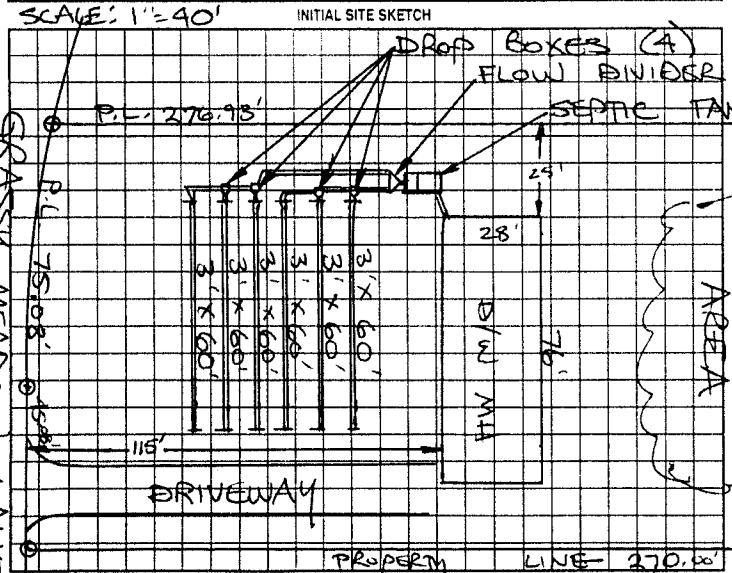

AS BUILT SKETCH

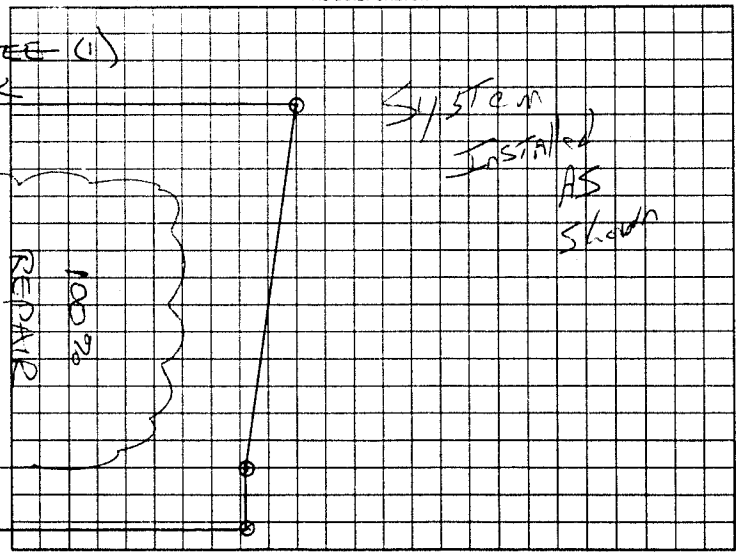

Permit can be suspended or revoked if any false information is supplied toward securing the permit/any unauthorized changes are made to the site/any unauthorized changes are made in the installation of the system. Improvement Permit with plat valid without expiration. Improvement Permit with site plan valid for sixty months. Authorization to Construct is valid for a period equal to that of Improvement Permit – not to exceed sixty months.

Signed: ____ date 3-29-00 Installed by: A. L. BACK / Hoe

Improvement Permit by: STEVE HEDRICK date 3-24-00 Operation Permit by: C. Potter date April 6, 2000

Authorization to Construct by: STEVE HEDRICK date 3-24-00 Existing System Inspection by: ____ date ____

HEALTH DEPT. COPY WHITE OWNER COPY (FINAL) YELLOW OWNER COPY (INITIAL) PINK