IREDELL COUNTY HEALTH DEPARTMENT

Const. Auth

STATESVILLE 704-878-5305 MOORESVILLE 704-664-5281

IMPROVEMENT PERMIT / ~~CERTIFICATE OF COMPLETION~~ / OPERATION PERMIT / EXISTING SYSTEM INSPECTION

PROPERTY DESCRIPTION NO. 26004 DATE July 1, '97 TAX MAP NO. 4738006849 (pt.) Watershed: ☑ Yes ☐ No

OWNER OR CONTRACTOR Phil Craven PHONE: Business _____ Home (910) 672-2269

ADDRESS 1534 Lake Country Dr, Asheboro, NC 27203

LOCATION 115 N. from Statesville TR Branchwood Rd ~ 1-1½ miles on left

SUBDIVISION Ridgecrest BLOCK / SECTION _____ LOT 31 LOT AREA ± .723 Ac SITE CLASS. PS DESIGN FLOW 360 gpd L.T.A.R. .3

Septic Tank: 1000 Gallons; STB 1012 Date 4-5-98

Pump Tank: _____ Gallons; PT _____ Date _____

Pump Make: _____ Model _____ Serial No. _____

Nitrification Field: No Fields 1 Square Feet 1200 Linear Feet 400

No Lines 3 @ 133' Trench Width 36" Max Trench Bottom Depth 24" Gravel Depth 12"

☑ New System ☐ Repair System Type: I, II, III, IV, V, VI

System Description: gravity conventional

Repair System Description: same

Maintenance Agreement Required: ☐ Yes ☑ No

☐ House/Mod. Home No. Bedrooms 3

☑ Mobile Home DW No. Bathrooms 2

☐ Business No. Employees _____

☐ Other _____

☐ Slab ☑ Crawl Space ☐ Basement w/plumbing ☐ Basement wo/plumbing


Water Supply: ☐ Individual ☐ Community ☑ Public

Comments: Septic installer note max. trench bottom depth

Comments:

1" = 50'

INITIAL SITE SKETCH

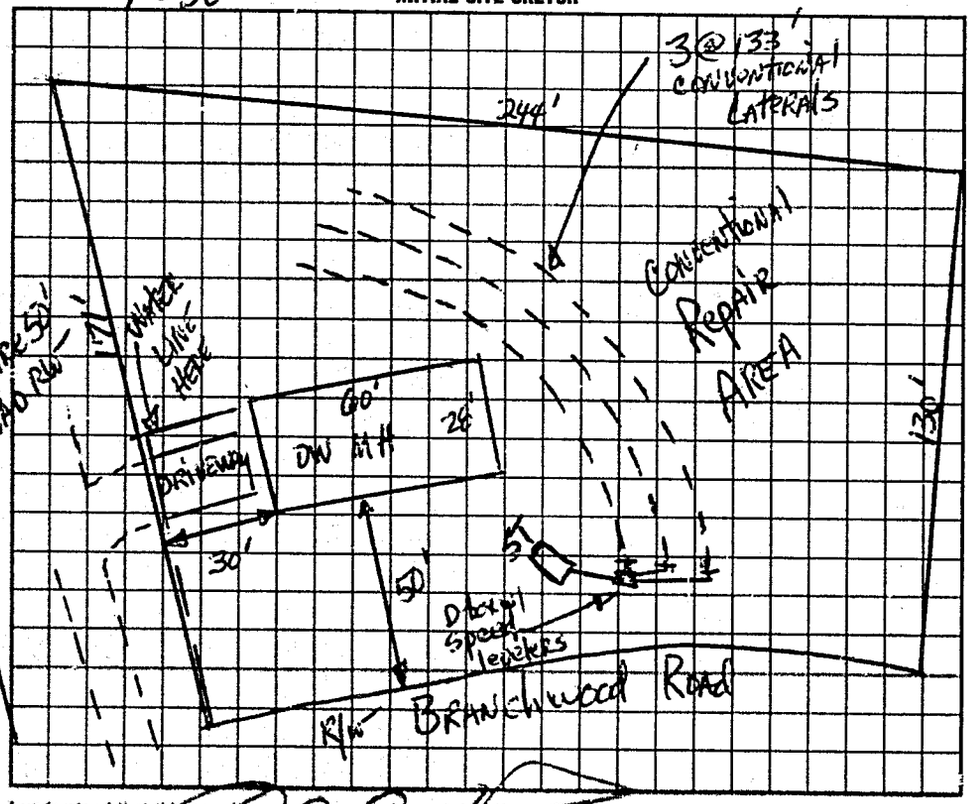

AS BUILT SKETCH

Installed as shown

I understand that this permit can be suspended or revoked if any false information is supplied toward securing the permit/any unauthorized changes are made to the site/any unauthorized changes are made in the installation of the system. Improvement Permit is valid for 60 months from date of issuance.

Signed: _____

Improvement Permit by: Construction Authorization DR Turner, RS date 7-1-97

DR Turner, RS date 7-1-97

Installed by: A-1 Backhoe

Certificate of Completion by: _____ date _____

Operation Permit by Mat Cox RS date 6-10-98

WHITE DEPT COPY WITH INSPECTION COPY (FINAL) GREEN OWNER COPY (FINAL) YELLOW INSPECTION COPY (INITIAL) PINK OWNER COPY (INITIAL) GOLD

68200