IREDELL COUNTY HEALTH DEPARTMENT

STATESVILLE 704-878-5305 MOORESVILLE 704-664-5281

IMPROVEMENT PERMIT / AUTHORIZATION TO CONSTRUCT / OPERATION PERMIT / EXISTING SYSTEM INSPECTION

PERMIT# 075719 PIN# 4738 01 4179 (PART) DATE 8-18-98

OWNER OR CONTRACTOR CRAVEN + OTHERS PHONE: Business (910) 672-2269 Home

ADDRESS P.O. BOX 2257 ASHEBORO NC 27204

LOCATION NC 115 N, TR BRANCHWOOD, TL FOREST GROVE, 2ND LOT ON RIGHT

SUBDIVISION RIDGECREST BLOCK / SECTION II LOT 32 LOT AREA 0.713 ACRE SITE CLASS PS DESIGN FLOW 360 L.T.A.R. 0.30 GPD/FT²

Septic Tank: 1000 Gallons; STB 1012 Date 4-17-98
Pump Tank: _____ Gallons; PT _____ Date _____
Pump Make: _____ Model _____ Serial No. _____
Nitrification Field: No Fields 1 Square Feet 1200 Linear Feet 400
No Lines FOUR Trench Width 36" Max Trench Bottom Depth 30" Gravel Depth 12"

☑ New System ☐ Repair System Type: I, (II), III, IV, V, VI
System Description: CONVENTIONAL GRAVITY
Repair System Description: 25% REDUCTION PUMP / GRAVITY
Maintenance Agreement Required: ☐ Yes ☑ No

☐ House/Mod. Home ☑ Mobile Home ☐ Business ☐ Other
No. Bedrooms 3 No. Bathrooms 2 No. Employees ___


Water Supply: ☐ Individual ☑ Public ☐ Community

☐ Slab ☑ Crawl Space ☐ Basement w/plumbing ☐ Basement wo/plumbing


Comments:/Conditions: CONSTRUCT SUBSURFACE INTERCEPT DRAINAGE DITCH AT LOCATION SHOWN BEGINNING 42" DEEP AT TO DAYLIGHT

Comments:/Conditions: SYSTEM INSTALLED 11-30 98 SUBSURFACE INTERCEPT DRAINAGE DITCH REMAINS TO BE INSTALLED.

INITIAL SITE SKETCH

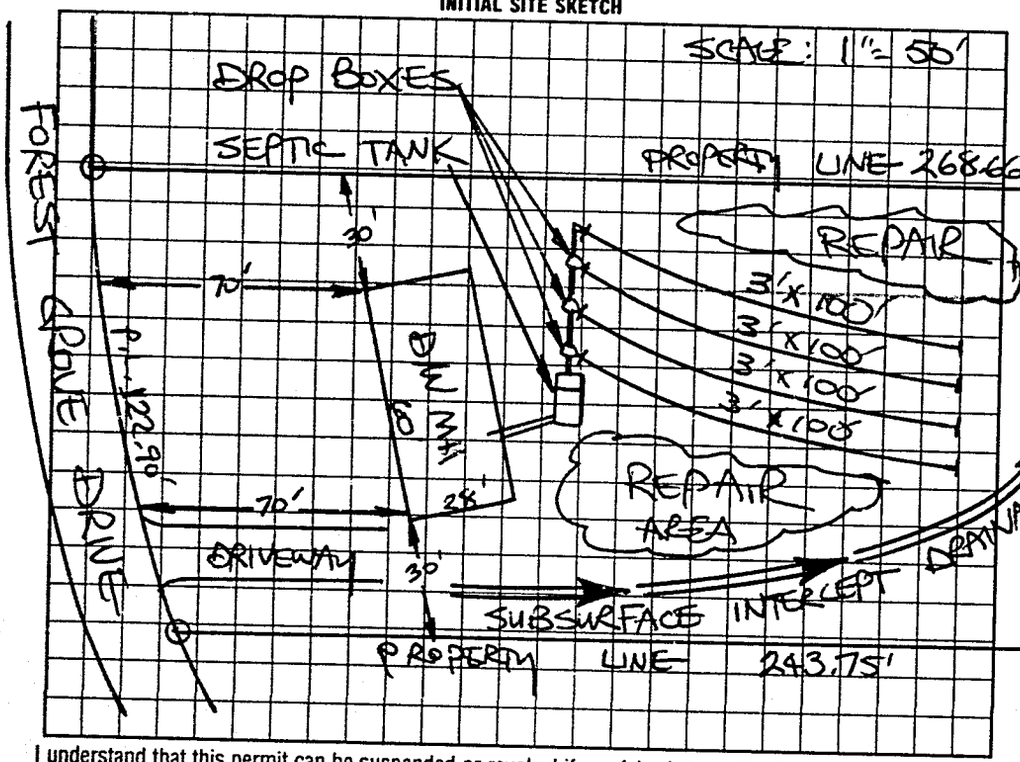

AS BUILT SKETCH

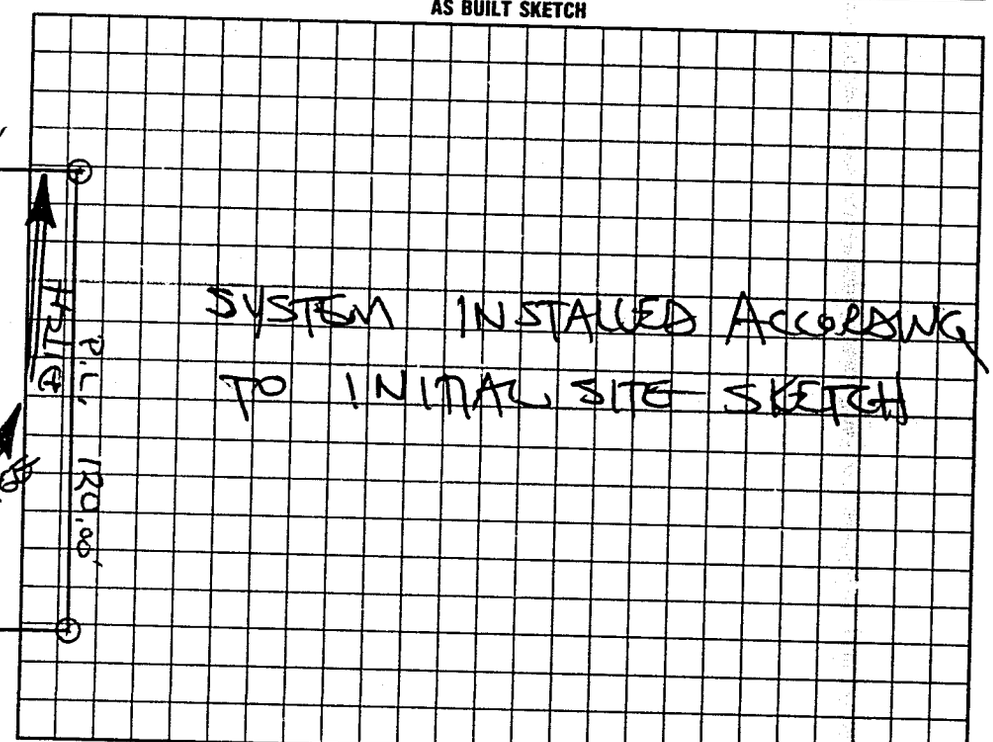

I understand that this permit can be suspended or revoked if any false information is supplied toward securing the permit/any unauthorized changes are made to the site/any unauthorized changes are made in the installation of the system. Improvement Permit with plat valid without expiration. Improvement Permit with site plan valid for sixty months. Authorization to Construct is valid for a period equal to that of Improvement Permit – not to exceed sixty months.

Signed: _____ date 8-19-98 Installed by: A-1 BACKHOE

Improvement Permit by: STEVE HEDRICK date 8-18-98 Operation Permit by: STEVE HEDRICK date 12-2-98

Authorization to Construct by: STEVE HEDRICK date 8-18-98 Existing System Inspection by: _____ date _____

HEALTH DEPT COPY WHITE INSPECTION COPY (FINAL) GREEN OWNER COPY (FINAL) YELLOW INSPECTION COPY (INITIAL) PINK OWNER COPY (INITIAL) GOLD