IREDELL COUNTY HEALTH DEPARTMENT

STATESVILLE 704-878-5305 MOORESVILLE 704-664-5281

IMPROVEMENT PERMIT / AUTHORIZATION TO CONSTRUCT / OPERATION PERMIT / EXISTING SYSTEM INSPECTION

PERMIT# 075726 PIN# 4738 01 4179 (PT) DATE 12-14-98

OWNER OR CONTRACTOR CRAVEN & OTHERS PHONE: Business (910) 672-2369 Home

ADDRESS P.O. BOX 2257, ASHEBORO, NC 27204

LOCATION NC 115 N TR BRANCHWOOD, TL FOREST GROVE DRIVE, 2ND LOT ON LEFT

SUBDIVISION RIDGECREST BLOCK / SECTION I LOT 81 LOT AREA 0.688 Acre SITE CLASS PS DESIGN FLOW 360 L.T.A.R. 0.30 GPD/FT²

Septic Tank: 1000 Gallons; STB 1012 Date 1-10-99
Pump Tank: Gallons; PT Date
Pump Make: Model Serial No
Nitrification Field: No Fields 1 Square Feet 1200 Linear Feet 400
No Lines FOUR Trench Width 36" Max Trench Bottom Depth 24" Gravel Depth 12"

System Type: I II III IV V
✓ New System Repair System
System Description: CONVENTIONAL GRAVITY
Repair System Description: CONV. GRAVITY
Maintenance Agreement Required: Yes No ✓
Slab ✓ Crawl Space Basement w/plumbing Basement wo/plumbing


✓ House/Mod Home No. Bedrooms 3
✓ Mobile Home No. Bathrooms 2
Business No. Employees
Other

Water Supply:
☐ Individual
✓ Public
☐ Community

Comments/Conditions: INSTALL LINES ON CONTOUR, AS FLAGGED, NO DEEPER THAN 24".

Comments/Conditions

SCALE: 1"=40' INITIAL SITE SKETCH

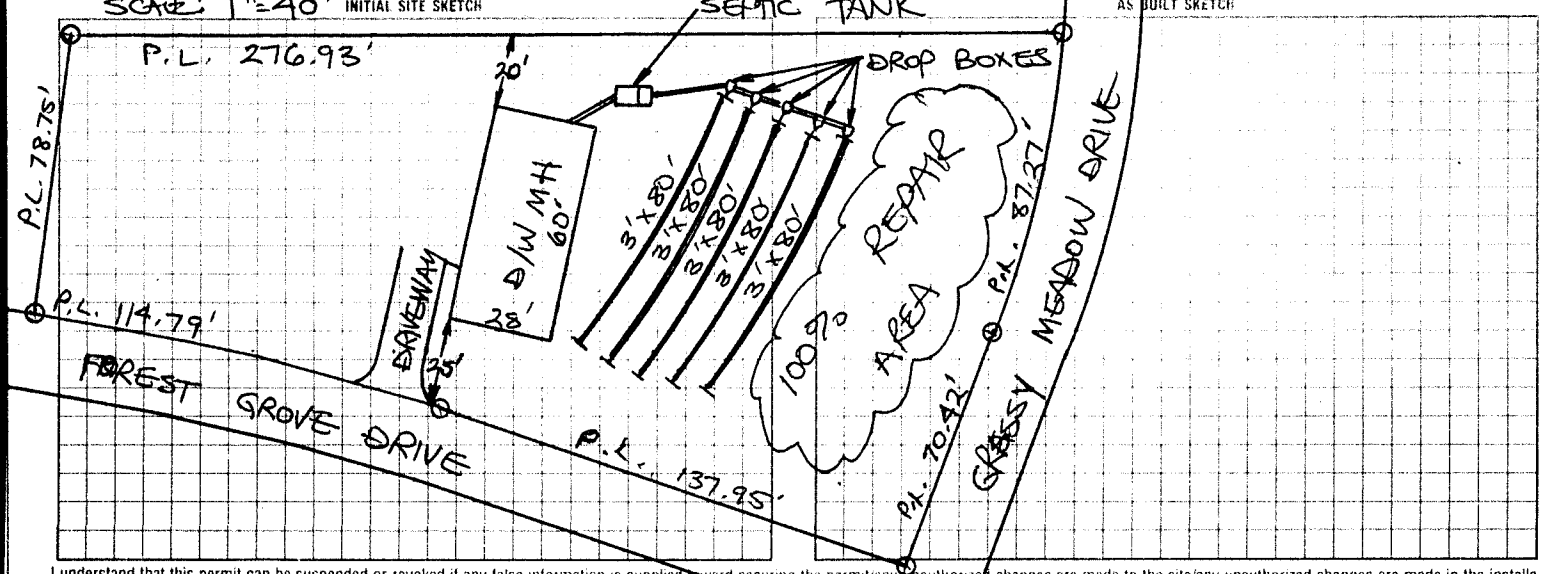

AS BUILT SKETCH

I understand that this permit can be suspended or revoked if any false information is supplied toward securing the permit/any unauthorized changes are made to the site/any unauthorized changes are made in the installation of the system. Improvement Permit with plat valid without expiration. Improvement Permit with site plan valid for sixty months. Authorization to Construct is valid for a period equal to that of Improvement Permit – not to exceed sixty months.

Signed [signature] date 17 Dec 98 Installed by: A-1 Backhoe

Improvement Permit by: STEVE HEDRICK date 12-14-98 Operation Permit by: [signature] date 3-25-99

Authorization to Construct by: STEVE HEDRICK date 12-14-98 Existing System Inspection by: date

HEALTH DEPT. COPY: WHITE INSPECTION COPY (FINAL): GREEN OWNER COPY (FINAL): YELLOW INSPECTION COPY (INITIAL): PINK OWNER COPY (INITIAL): GOLD