IREDELL COUNTY HEALTH DEPARTMENT

Statesville Office (704) 878-5305 Mooresville Office (704) 660-3625 PERMIT # 212348

IMPROVEMENT PERMIT / AUTHORIZATION TO CONSTRUCT / OPERATION PERMIT / EXISTING SYSTEM

PIN # 4738113424

APPLICANT: 1st Choice Housing INC APPLICANT ADDRESS: 16507-6 Northcross Dr.

SITE ADDRESS: 138 Forest Grove Dr. - Statesville PHONE: 704-883-8228 ALT. PHONE: N/A

SITE DIRECTIONS: Hwy 115 N TR Branchwood Rd TL Forest Grove Dr. Home @ End on Right

SUBDIVISION: Ridgecrest SECTION: 2 of 4 LOT # 36 LOT AREA: 1.1 acres DESIGN FLOW: 360gpd L.T.A.R.: Existing


Septic Tank	Existing (gal)	STB	Date	☐ New System ☐ Repair ☐ Expansion	System Type: I II (III) IV V VI	☑ Residence	No. Bedrooms 3
Pump Tank	(gal)	PT	Date	System Description: PPBPS		☐ Business	No. Persons 6
Pump Make	Model		Serial #	Repair System Description:		☐ Other	No. Employees
# Nitrification Fields	Ex # Lines Ex		Linear Ft: Ex	Maintenance Agreement Required:	☐ YES ☑ NO	☐ Slab	☑ Crawl Space
Trench Width	Ex Max. Trench Bottom Depth Ex		Gravel Depth Ex		☑ GRAVITY ☐ PRESSURE	☐ Basement w/plumbing	☐ Basement w/o plumbing

Water Supply: ☐ Private ☑ Public ☐ Community


Comments / Conditions:

- Maintain a minimum of 5' between home foundation & all components of septic tank system.

INITIAL SITE SKETCH

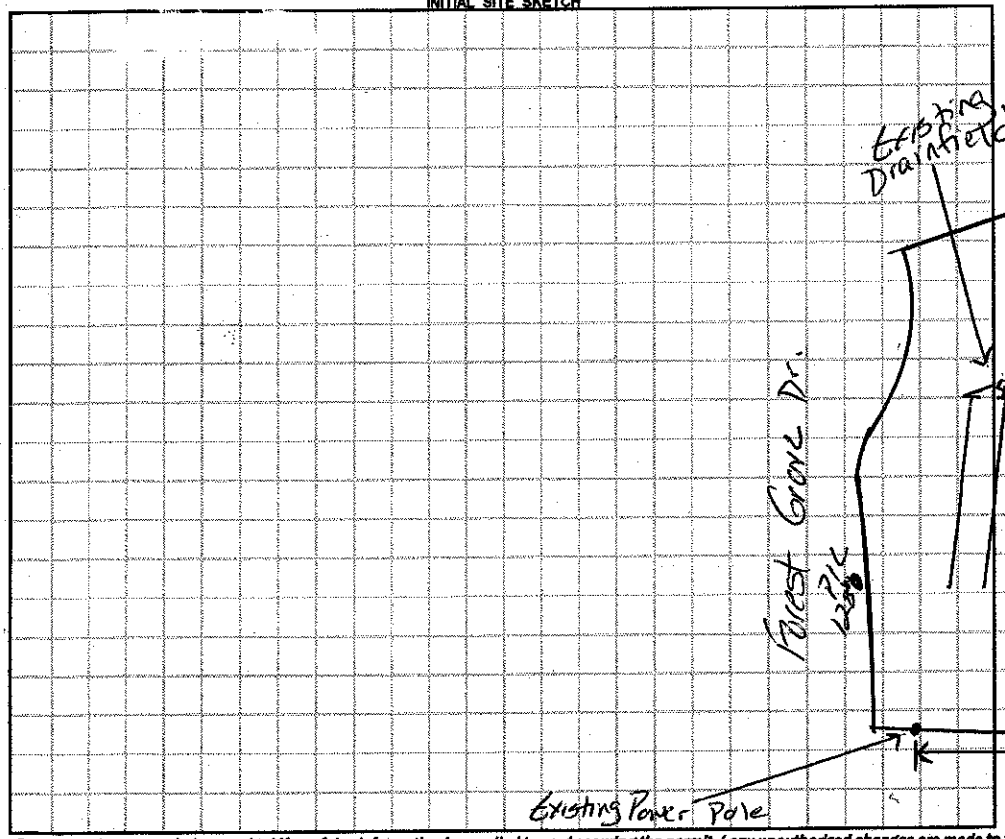

AS BUILT SKETCH

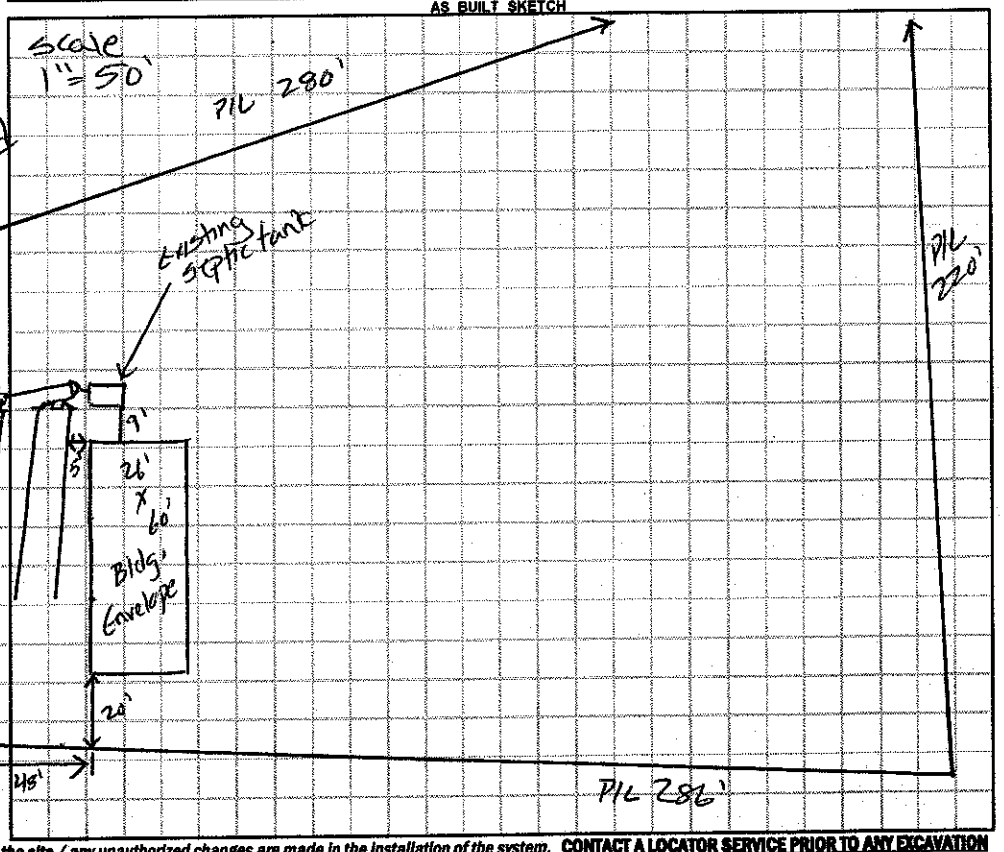

Permit can be suspended or revoked if any false information is supplied toward securing the permit / any unauthorized changes are made to the site / any unauthorized changes are made in the installation of the system. **CONTACT A LOCATOR SERVICE PRIOR TO ANY EXCAVATION**

☐ **IMPROVEMENT PERMIT** *with plat valid without expiration.* ☐ **IMPROVEMENT PERMIT** *with site plan valid for 60 mos.* ☐ **AUTHORIZATION TO CONSTRUCT** *valid for period equal to IMPROVEMENT PERMIT--not to exceed 60 mo.*

Owner / Applicant Signature: Issued w/o signature 8/18/15 Date: Pink never picked up. Installed by:

IMPROVEMENT PERMIT by: Date: OPERATION PERMIT by: Date:

AUTHORIZATION TO CONSTRUCT by: Date: Existing System Inspected by: Justin Henderson Date: 8-17-15

Health Dept. Copy - WHITE Applicant (Final Approval) - YELLOW Applicant (Conditional Approval) - PINK