IREDELL COUNTY HEALTH DEPARTMENT

STATESVILLE 704-878-5305 MOORESVILLE 704-664-5281

IMPROVEMENT PERMIT / AUTHORIZATION TO CONSTRUCT / OPERATION PERMIT / EXISTING SYSTEM INSPECTION

PERMIT# 075722 PIN# 4738 01 4179 (PART)

OWNER OR CONTRACTOR CRAVEN & OTHERS PHONE: Business (910) 672-2269 Home 872-6645 DATE 9-5-98

ADDRESS P.O. BOX 2257, ASHEBORO, NC 27204

LOCATION NC 115 N, TR BRANDYWOOD ROAD, TL FOREST GROVE 5TH LOT ON RIGHT

SUBDIVISION RIDGECREST BLOCK / SECTION II #35 LOT [redacted] LOT AREA 1.208 ACRES SITE CLASS. RS1 DESIGN FLOW 360 L.T.A.R. 0.4 GPD/FT²

Septic Tank: 1000 Gallons; STB 786 Date 9-28-98

Pump Tank: _____ Gallons; PT _____ Date _____

Pump Make: _____ Model _____ Serial No. _____

Nitrification Field: No Fields 1 Square Feet 900 Linear Feet 300

No Lines THREE Trench Width 36" Max Trench Bottom Depth 36" Gravel Depth 12"

☑ New System ☐ Repair System Type: (I), II, III, IV, V, VI

System Description: CONVENTIONAL GRAVITY

Repair System Description: CONV. GRAVITY

Maintenance Agreement Required: ☐ Yes ☑ No

☐ House/Mod. Home ☑ Mobile Home ☐ Business ☐ Other

No. Bedrooms 3 No. Bathrooms 2 No. Employees _____


☐ Slab ☑ Crawl Space ☐ Basement w/plumbing ☐ Basement wo/plumbing

Water Supply: ☐ Individual ☑ Public ☐ Community


Comments:/Conditions: INSTALL SUBSURFACE INTERCEPT DRAINAGE DITCH AT LOCATION SHOWN BEGINNING 48 INCHES DEEP OUT TO DAYLIGHT

Comments:/Conditions:

P.L. 286.14' **INITIAL SITE SKETCH** SCALE: 1" = 50'

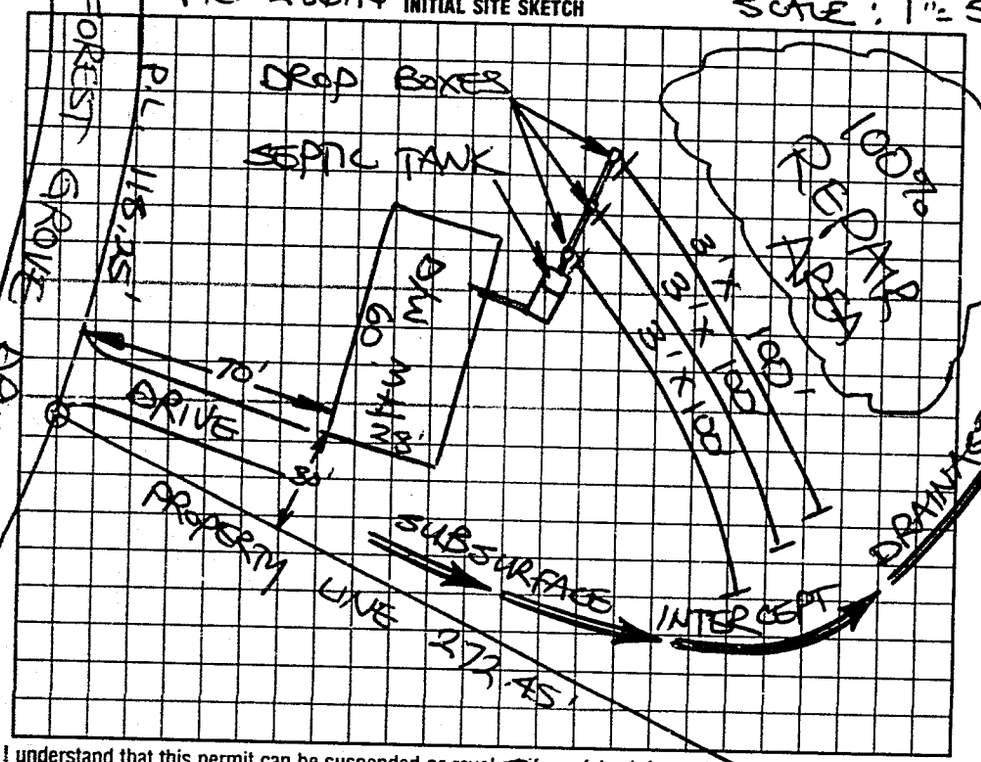

AS BUILT SKETCH

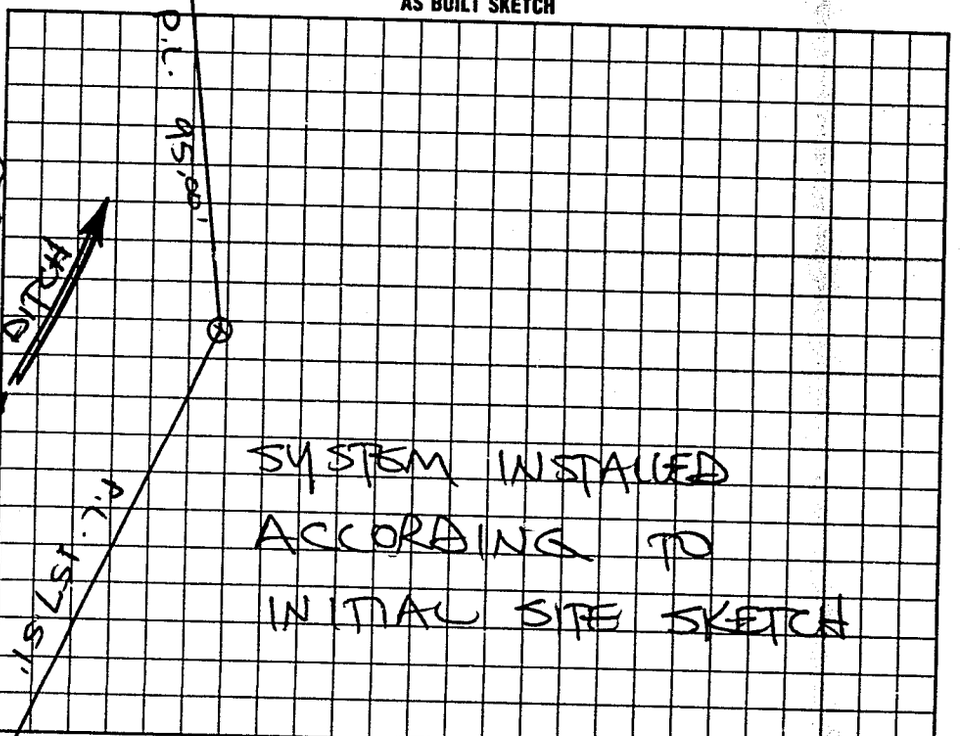

I understand that this permit can be suspended or revoked if any false information is supplied toward securing the permit/any unauthorized changes are made to the site/any unauthorized changes are made in the installation of the system. Improvement Permit with plat valid without expiration. Improvement Permit with site plan valid for sixty months. Authorization to Construct is valid for a period equal to that of Improvement Permit – not to exceed sixty months.

Signed: _____ date _____

Improvement Permit by: STEVE HEDRICK date 9-5-98

Authorization to Construct by: STEVE HEDRICK date 9-5-98

Installed by: HARVEY LEATHMAN'S SEPTIC TANK SER.

Operation Permit by: STEVE HEDRICK date 12-1-98

Existing System Inspection by: _____ date _____

HEALTH DEPT. COPY: WHITE INSPECTION COPY (FINAL): GREEN OWNER COPY (FINAL): YELLOW INSPECTION COPY (INITIAL): PINK OWNER COPY (INITIAL): GOLD