IREDELL COUNTY HEALTH DEPARTMENT

STATESVILLE 704-878-5305 (e1) MOORESVILLE 704-664-5281

IMPROVEMENT PERMIT / AUTHORIZATION TO CONSTRUCT / OPERATION PERMIT / EXISTING SYSTEM INSPECTION

PERMIT# 102379 PIN# 4738-38-9575 7489 DATE 10-15-01

OWNER OR CONTRACTOR KENNETH L. MARSH PHONE: Business Home (704) 876-2415

ADDRESS 311 RIVER RUN ROAD, STATESVILLE, NC 28625

LOCATION NC 115 N, TR S. CHIPLEY FORD RD, TL RIVER RUN RD, TL BRAMBLEWOOD RD, BEHIND #132 BRAMBLEWOOD

SUBDIVISION _____ BLOCK / SECTION _____ LOT _____ LOT AREA 3.38 ACRES SITE CLASS. PS DESIGN FLOW 240 L.T.A.R. 0.40 GPD/FT²

Septic Tank: 1000 Gallons; STB 1007 Date 5-17-04
Pump Tank: _____ Gallons; PT _____ Date _____
Pump Make: _____ Model _____ Serial No. _____
Nitrification Field: No Fields 1 Square Feet 600 Linear Feet 200
No Lines TWO Trench Width 36" Max Trench Bottom Depth 36" Gravel Depth 12"

☑ New System ☐ Repair System Type: I, II, III, IV, V, VI
System Description: CONVENTIONAL GRAVITY
Repair System Description: CONV. GRAVITY
Maintenance Agreement Required: ☐ Yes ☑ No


☑ House/Mod. Home No. Bedrooms 1
☐ Mobile Home No. Bathrooms 1
☐ Business No. Employees _____
☐ Other _____
☐ Slab ☑ Crawl Space ☐ Basement w/plumbing ☐ Basement wo/plumbing

Water Supply: ☐ Individual ☑ Public ☐ Community

Comments:/Conditions:

Comments:/Conditions: SEPTIC TANK WITH MARKER INSTALLED USING RED "POLY LOK" FILTER

INITIAL SITE SKETCH SCALE: 1"=40'

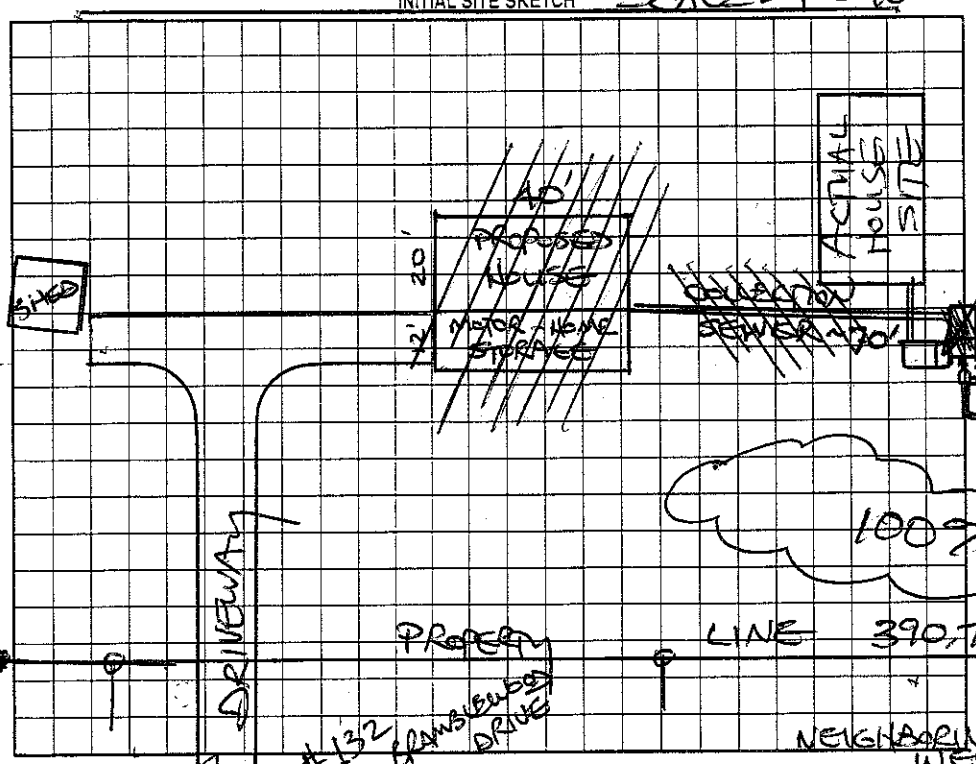

AS BUILT SKETCH

SYSTEM ALTERED AS SHOWN WITH PRIOR HEALTH DEPT. APPROVAL

Permit can be suspended or revoked if any false information is supplied toward securing the permit/any unauthorized changes are made to the site/any unauthorized changes are made in the installation of the system. Improvement Permit with plat valid without expiration. Improvement Permit with site plan valid for sixty months. Authorization to Construct is valid for a period equal to that of Improvement Permit – not to exceed sixty months.

Signed: Kenneth L Marsh date 10-15-01 Installed by: AUSTIN & AUSTIN BLDRS.

Improvement Permit by: STEVE HEDRICK date 10-15-01 Operation Permit by: STEVE HEDRICK date 7-29-04

Authorization to Construct by: STEVE HEDRICK date 10-15-01 Existing System Inspection by: _____ date _____

BRAMBLEWOOD DR.

HEALTH DEPT. COPY: WHITE OWNER COPY (FINAL): YELLOW OWNER COPY (INITIAL): PINK