IREDELL COUNTY HEALTH DEPARTMENT

STATESVILLE 704-878-5305 MOORESVILLE 704-664-5281

IMPROVEMENT PERMIT / AUTHORIZATION TO CONSTRUCT / OPERATION PERMIT / EXISTING SYSTEM INSPECTION

PERMIT# 072519 PIN# 4738 38 8190 DATE 3-26-98

OWNER OR CONTRACTOR HOPE BRO BLDRS ADDRESS 1120 BARKLEY ROAD STATESVILLE, NC 28677 PHONE: Business 872-4111 Home

LOCATION N.C. 115 N. TR 3. CHIPLEY FORD, TL RIVER RUN ROAD, TL BRAMBLEWOOD DRIVE, 5TH ON LEFT

SUBDIVISION RIVER RUN BLOCK / SECTION II LOT 62 LOT AREA 0.484 ACRE SITE CLASS. PS DESIGN FLOW 360 L.T.A.R. 0.30 GPD/FT²

Septic Tank: 1000 Gallons; STB 1012 Date 5-2-98
Pump Tank: Gallons; PT Date
Pump Make: Model Serial No.
Nitrification Field: No Fields 1 Square Feet EQ. TO 1200 Linear Feet 300+
No Lines FIVE Trench Width 36" Max Trench Bottom Depth 36" ~~Gravel~~ Depth 6" SAND

☑ New System ☐ Repair System Type: I, II, (III), V, V, VI
System Description: CHAMBERED GRAVITY
Repair System Description: CHAMBERED GRAVITY
Maintenance Agreement Required: ☐ Yes ☑ No


☑ House/Mod. Home No. Bedrooms 3
☐ Mobile Home No. Bathrooms 2
☐ Business No. Employees
☐ Other
☐ Slab ☑ Crawl Space ☐ Basement w/plumbing ☐ Basement wo/plumbing

Water Supply: ☑ Individual ☐ Public ☐ Community WELL

Comments:/Conditions: ① KEEP SYSTEM MAXIMUM FEASIBLE DISTANCE (65') FROM WELL ② INSTALL FIFTY CHAMBERS IN FIVE EQUAL LENGTH LINES AS SHOWN

Comments:/Conditions:

INITIAL SITE SKETCH

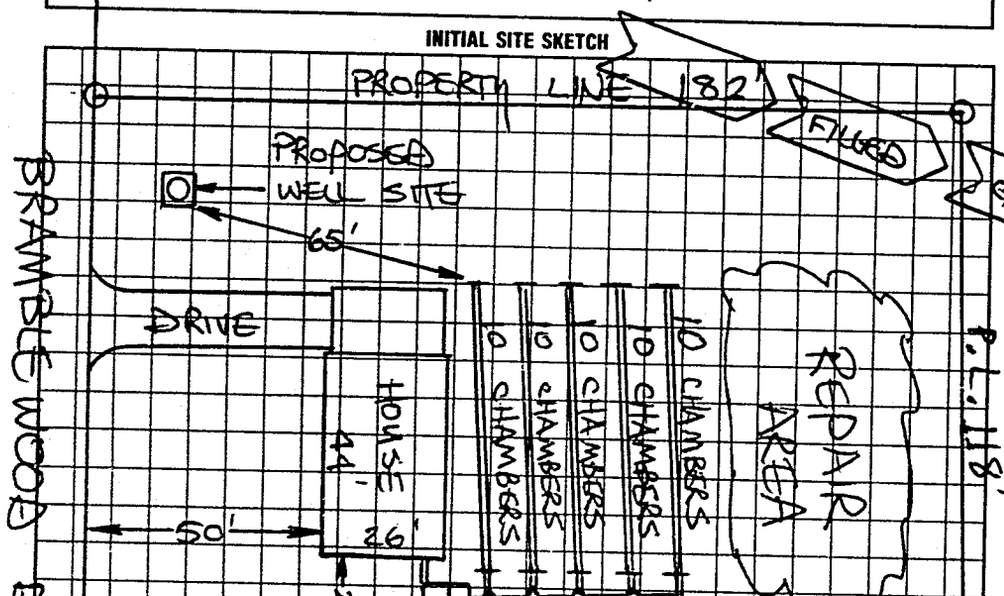

AS BUILT SKETCH

SYSTEM INSTALLED ACCORDING TO INITIAL SITE SKETCH

I understand that this permit can be suspended or revoked if any false information is supplied toward securing the permit/any unauthorized changes are made to the site/any unauthorized changes are made in the installation of the system. Improvement Permit with plat valid without expiration. Improvement Permit with site plan valid for sixty months. Authorization to Construct is valid for a period equal to that of Improvement Permit – not to exceed sixty months.

Signed: Terry A. Hope

Improvement Permit by: STEVE HEDRICK date 3-26-98

Authorization to Construct by: STEVE HEDRICK date 3-26-98

Installed by: ARNIE DUNCAN

Operation Permit by: STEVE HEDRICK date 7-30-98

Existing System Inspection by: date

HEALTH DEPT COPY WHITE INSPECTION COPY (FINAL) GREEN OWNER COPY (FINAL) YELLOW INSPECTION COPY (INITIAL) PINK OWNER COPY (INITIAL) GOLD