IREDELL COUNTY HEALTH DEPARTMENT

STATESVILLE 704-878-5305 MOORESVILLE 704-664-5281 58825

IMPROVEMENT PERMIT / CERTIFICATE OF COMPLETION / OPERATION PERMIT / EXISTING SYSTEM INSPECTION

PROPERTY DESCRIPTION NO. 22494 DATE 12-7-95 TAX MAP NO. 13E-1-A-57 Watershed: IVA (Y/N)

OWNER OR CONTRACTOR THOMAS BEATTY PHONE: Business Home 872-9511

ADDRESS P.O. BOX 5099, STATESVILLE, NC 28677

LOCATION NC 115 N, TR CHIPLEY FORD RD, TL RIVER RUN RD, TL BRAMBLEWOOD DR, LOT ON (R)

SUBDIVISION RIVER RUN BLOCK / SECTION II LOT 57 LOT AREA 115' X 184' SITE CLASS. FS DESIGN FLOW 360 L.T.A.R.

Septic Tank: 1000 Gallons; STB 1012 Date 5-5-96

Pump Tank: Gallons; PT Date

Pump Make: Model EQUIVALENT Serial No.

Nitrification Field: No Fields 1 Square Feet 70 1200 Linear Feet 300

No Lines 5 Trench Width 36" Max Trench Bottom Depth 24-36" Gravel Depth N/A

☑ New System ☐ Repair System Type: I, II, (III) IV, V, VI

System Description: GRAVITY-FED CHAMBERS

Repair System Description: PUMP-FED CHAMBERS

Maintenance Agreement Required: ☐ Yes ☑ No

☑ House/Mod. Home No. Bedrooms 3

☐ Mobile Home No. Bathrooms 2

☐ Business No. Employees

☐ Other


☐ Slab ☑ Crawl Space ☐ Basement w/plumbing ☐ Basement wo/plumbing

Water Supply: ☑ Individual ☐ Community ☐ Public WELL

Comments ① USE 50 CHAMBERS INSTALLED IN FIVE EQUAL LENGTH LINES. ② KEEP SYSTEM MINIMUM 5' FROM HOUSE, 10' FROM PROPERTY LINE, 100' FROM WELL

Comments:

INITIAL SITE SKETCH

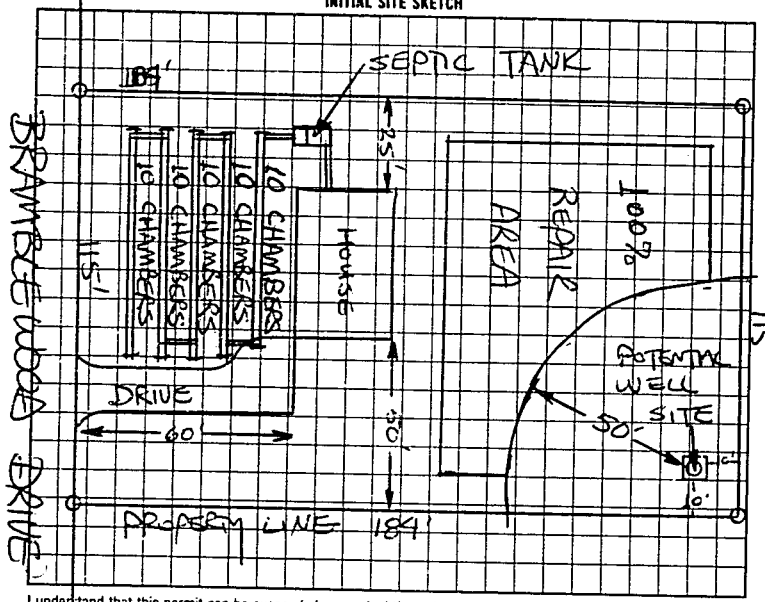

AS BUILT SKETCH

SYSTEM INSTALLED ACCORDING TO INITIAL SITE SKETCH

I understand that this permit can be suspended or revoked if any false information is supplied toward securing the permit/any unauthorized changes are made to the site/any unauthorized changes are made in the installation of the system.

AUTHORIZATION TO CONSTRUCT IS VALID FIVE (5) YEARS FROM DATE OF ISSUANCE. IMPROVEMENT PERMIT HAS NO EXPIRATION DATE.

Signed: I Bruce Pate

Improvement Permit by: STEVE HEDRICK date 12-7-95

Authorization to Construct

Existing System Inspection by: STEVE HEDRICK date 12-7-95

Installed by: Tommy Frye

~~Certificate of Completion by:~~ date

Operation Permit by: STEVE HEDRICK date 7-26-96

HEALTH DEPT. COPY: WHITE INSPECTION COPY (FINAL): GREEN OWNER COPY (FINAL): YELLOW INSPECTION COPY (INITIAL): PINK OWNER COPY (INITIAL): GOLD