IREDELL COUNTY HEALTH DEPARTMENT

Statesville Office (704) 878-5305 Mooresville Office (704) 660-3625

IMPROVEMENT PERMIT / AUTHORIZATION TO CONSTRUCT / OPERATION PERMIT / EXISTING SYSTEM

PERMIT # 207822

APPLICANT: David Fox PIN # 4738466647

SITE ADDRESS: 215 River Run Rd Statesville NC 28625 APPLICANT ADDRESS: 215 River Run Rd Statesville NC 28625

SITE DIRECTIONS: Hwy 115 N T/R Chipley Ford Rd T/L River Run Rd 2 miles on left PHONE: 704-902-1180 ALT. PHONE: N/A

SUBDIVISION: N/A SECTION: N/A LOT # N/A LOT AREA: 5.49ac

DESIGN FLOW: Ex L.T.A.R.: Ex

Septic Tank Existing (gal) STB Date

Pump Tank (gal) PT Date

Pump Make Model Serial #

Nitrification Fields Ex # Lines Ex Linear Ft: Ex

Trench Width Ex Max. Trench Bottom Depth Ex Gravel Depth Ex

☐ New System ☐ Repair ☐ Expansion System Type: I II III IV V VI

System Description: Existing

Repair System Description:

Maintenance Agreement Required: ☐ YES ☒ NO

☒ GRAVITY ☐ PRESSURE

☒ Residence ☐ Business ☐ Other ☐ Slab ☒ Basement w/plumbing

No. Bedrooms Ex No. Persons Ex No. Employees ☐ Crawl Space

Water Supply: ☑ Private ☐ Public ☐ Community


☐ Basement w/o plumbing

Comments / Conditions: All building foundations must be 35' from any part of STS and 325' from any well

INITIAL SITE SKETCH



AS BUILT SKETCH

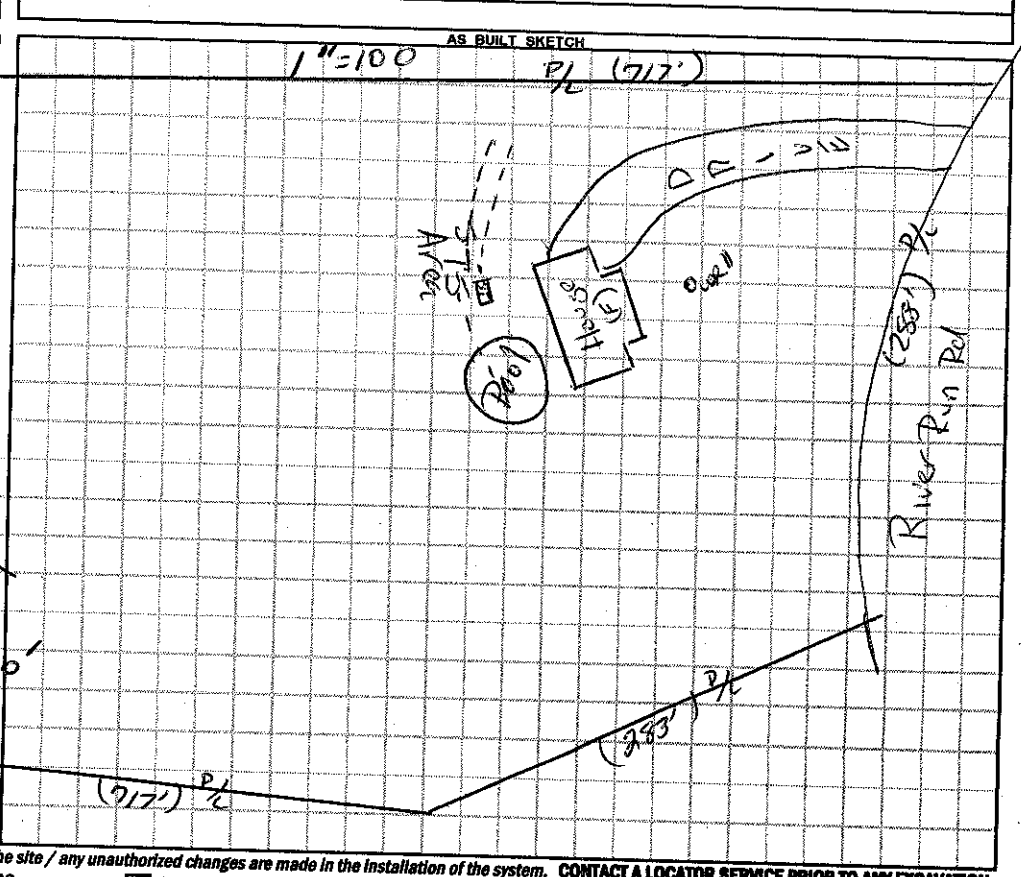

Permit can be suspended or revoked if any false information is supplied toward securing the permit / any unauthorized changes are made to the site / any unauthorized changes are made in the installation of the system. **CONTACT A LOCATOR SERVICE PRIOR TO ANY EXCAVATION**

☐ **IMPROVEMENT PERMIT** *with plat valid without expiration.* ☐ **IMPROVEMENT PERMIT** *with site plan valid for 60 mos.* ☐ **AUTHORIZATION TO CONSTRUCT** *valid for period equal to IMPROVEMENT PERMIT--not to exceed 60 mo.*

Owner / Applicant Signature: David Fox Date: 1-15-15 Installed by:

IMPROVEMENT PERMIT by: Date: OPERATION PERMIT by: Date:

AUTHORIZATION TO CONSTRUCT by: Date: Existing System Inspected by: Date: 1/13/15

Health Dept. Copy - WHITE Applicant (Final Approval) - YELLOW Applicant (Conditional Approval) - PINK