IREDELL COUNTY HEALTH DEPARTMENT

STATESVILLE 704-878-5305 MOORESVILLE 704-664-5281

IMPROVEMENT PERMIT / CERTIFICATE OF COMPLETION / OPERATION PERMIT / EXISTING SYSTEM INSPECTION

PROPERTY DESCRIPTION NO. 16861 DATE 6/24/93 TAX MAP NO. 13E-1-A-63

OWNER OR CONTRACTOR HOPE BROTHERS BUILDING PHONE: Business 872-4111 Home

ADDRESS 1120 BARKLEY ROAD, STATESVILLE NC 28677

LOCATION NC115 N, TR S, CHIPLEY FORD RD, TL RIVER RUN RD, TL BRAMBLEWOOD DR, 4TH LOT ON (R) 0.40 GPD/FT2

SUBDIVISION RIVERRUN BLOCK / SECTION II LOT 63 LOT AREA 115'x180' SITE CLASS. PS L.T.A.R.

Water Supply: ☑ Individual ☐ Community ☐ Public WELL

Septic Tank: 1000 Gallons; STB 1782 Date 10/29/93

Pump Tank: Gallons; PT Date

Nitrification Field: No Fields 1 Square Feet 900 Linear Feet 300

No Lines 3 Trench Width 36" Trench Depth 18-36" Gravel Depth 12"

☑ New System ☐ Repair System Type: I (II) III IV V VI

System Description: CONV., GRAVITY

Repair System Description: PPBPS, PUMP

Maintenance Agreement Required: ☐ Yes ☑ No

☑ House/Mod. Home No. Bedrooms 3

☐ Mobile Home No. Bathrooms 2

☐ Business No. Employees

☐ Other

☐ Slab ☑ Crawl Space ☐ Basement w/plumbing ☐ Basement wo/plumbing

Garbage Disposal: ☐ Yes ☑ No


Auto. Dishwasher: ☑ Yes ☐ No

Auto. Washing Machine: ☑ Yes ☐ No

Other

Comments ① KEEP WELL MINIMUM 100' FROM SYSTEM ② INSTALL LINES ON CONTOUR, NO DEEPER THAN 36", 9' APART ON CENTER.

INITIAL SITE SKETCH

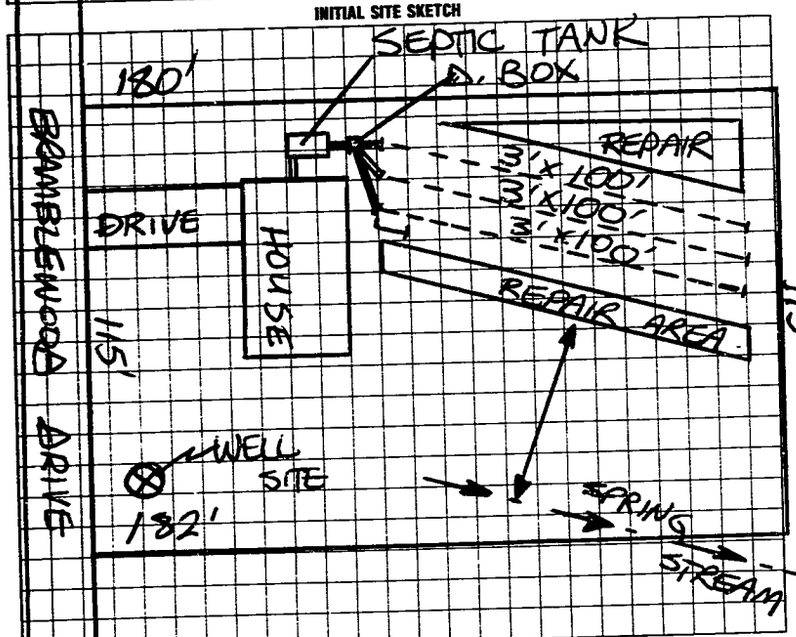

AS BUILT SKETCH

SYSTEM INSTALLED ACCORDING TO INITAL SITE SKETCH

I understand that this permit can be suspended or revoked if any false information is supplied toward securing the permit/any unauthorized changes are made to the site/any unauthorized changes are made in the installation of the system. Improvement Permit is valid for 60 months from date of issuance.

Signed:

Improvement Permit by: STEVE HEDRICK date 6/24/93

Existing System Inspection by: date

Installed by: ARNIE DUNCAN

Certificate of Completion by: STEVE HEDRICK date 12/3/93

Operation Permit by: date

HEALTH DEPT. COPY: WHITE INSPECTION COPY (FINAL): GREEN OWNER COPY (FINAL): YELLOW INSPECTION COPY (INITIAL): PINK OWNER COPY (INITIAL): GOLD