IREDELL COUNTY HEALTH DEPARTMENT

STATESVILLE 704-878-5305 MOORESVILLE 704-664-5281

IMPROVEMENT PERMIT / AUTHORIZATION TO CONSTRUCT / OPERATION PERMIT / EXISTING SYSTEM INSPECTION

PERMIT# 106854 PIN# 4738-48-1134 DATE 6-24-02

OWNER OR CONTRACTOR HOPE BROTHERS BUILDERS PHONE: Business 704-872-4111 Home

ADDRESS 601 BOND STREET STATESVILLE NC 28625

LOCATION NC 115 N TR S. CHIPLEY FORD, TL RIVER RUN RD, TL BRAMBLEWOOD DR, 3RD LOT ON LEFT

SUBDIVISION RIVER RUN BLOCK / SECTION 2 LOT 64 LOT AREA 0.47 ACRE SITE CLASS PS DESIGN FLOW 360 L.T.A.R. 0.40 GPD/SQFT

Septic Tank: 1000 Gallons; STB 1007 Date 5-12-04

Pump Tank: ____ Gallons; PT ____ Date ____

Pump Make: ____ Model ____ Serial No. ____

Nitrification Field: No Fields 1 Square Feet 900 Linear Feet 300

No Lines FOUR Trench Width 36" Max Trench Bottom Depth 30" Gravel Depth 12"

☑ New System ☐ Repair System Type: I, (II), III, IV, V, VI

System Description: CONVENTIONAL, GRAVITY

Repair System Description: 50% REDUCTION ROW

Maintenance Agreement Required: ☐ Yes ☑ No PRESSURE

☑ House/Mod. Home No. Bedrooms 3

☐ Mobile Home No. Bathrooms 2

☐ Business No. Employees ____

☐ Other ____


☐ Slab ☑ Crawl Space ☐ Basement w/plumbing ☐ Basement wo/plumbing

Water Supply: ☐ Individual ☑ Public ☐ Community

Comments:/Conditions: STUB-OUT AT LOCATION SHOWN AS SHALLOW AS POSSIBLE TO ALLOW FOR 30" MAXIMUM TRENCH DEPTH

Comments:/Conditions: ① Red Poly/ok filter ② #57 stone ③ No Riser on front of tank – shallower than 6"

INITIAL SITE SKETCH SCALE: 1" = 40'

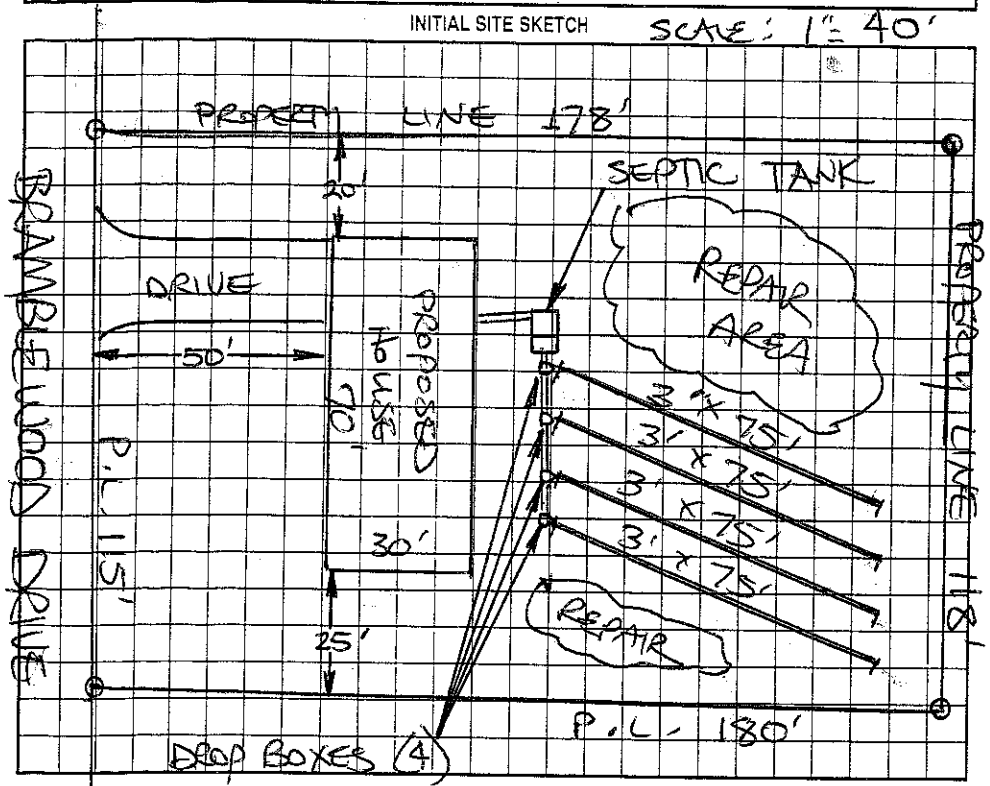

AS BUILT SKETCH

* System installed according to sketch

Permit can be suspended or revoked if any false information is supplied toward securing the permit/any unauthorized changes are made to the site/any unauthorized changes are made in the installation of the system. Improvement Permit with plat valid without expiration. Improvement Permit with site plan valid for sixty months. Authorization to Construct is valid for a period equal to that of Improvement Permit – not to exceed sixty months.

Signed: John A Hope, Jr date ____

Improvement Permit by: STEVE HEDRICK date 6-24-02

Authorization to Construct by: STEVE HEDRICK date 6-24-02

Installed by: James Hudler

Operation Permit by: [signature] 7-23-04

Existing System Inspection by: ____ date ____

HEALTH DEPT. COPY: WHITE OWNER COPY (FINAL): YELLOW OWNER COPY (INITIAL): PINK