IREDELL COUNTY HEALTH DEPARTMENT

STATESVILLE 704-878-5305 MOORESVILLE 704-664-5281

IMPROVEMENT PERMIT / CERTIFICATE OF COMPLETION / OPERATION PERMIT / EXISTING SYSTEM INSPECTION

PROPERTY DESCRIPTION NO. 11887 DATE 12/1/93 TAX MAP NO. 13E-1-A-55 Watershed: ☐ Yes ☒ No

OWNER OR CONTRACTOR J.L. HOPE PHONE: Business _____ Home _____

ADDRESS _____

LOCATION NC.115N, TR S. CHIPLEY FORD RD, TL RIVER RUN RD, TL PAVED STREET, 3rd LOT ON (R)

SUBDIVISION _____ BLOCK / SECTION _____ LOT _____ LOT AREA 0.472 AC SITE CLASS. PS DESIGN FLOW 360 L.T.A.R. 0.4 GPD/FT2

Septic Tank: 1000 Gallons; STB 358 Date 10/20/93

Pump Tank: _____ Gallons; PT _____ Date _____

Pump Make: _____ Model _____ Serial No. _____

Nitrification Field: No Fields 1 Square Feet 900 Linear Feet 300

No Lines 2 Trench Width 36" Max Trench Bottom Depth ~36" Gravel Depth 12"

☒ New System ☐ Repair System Type: I, II, III, IV, V, VI

System Description: CONV. GRAVITY

Repair System Description: CONV. GRAVITY

Maintenance Agreement Required: ☐ Yes ☒ No

☒ House/Mod. Home No. Bedrooms 3

☐ Mobile Home No. Bathrooms 2

☐ Business No. Employees _____

☐ Other _____

☐ Slab ☒ Crawl Space ☐ Basement w/plumbing ☐ Basement wo/plumbing


Water Supply: ☒ Individual ☐ Community ☐ Public

Comments:

Comments: KEEP WELL MAXIMUM FEASIBLE DISTANCE FROM SYSTEM, NOT LESS THAN 50'

INITIAL SITE SKETCH

AS BUILT SKETCH

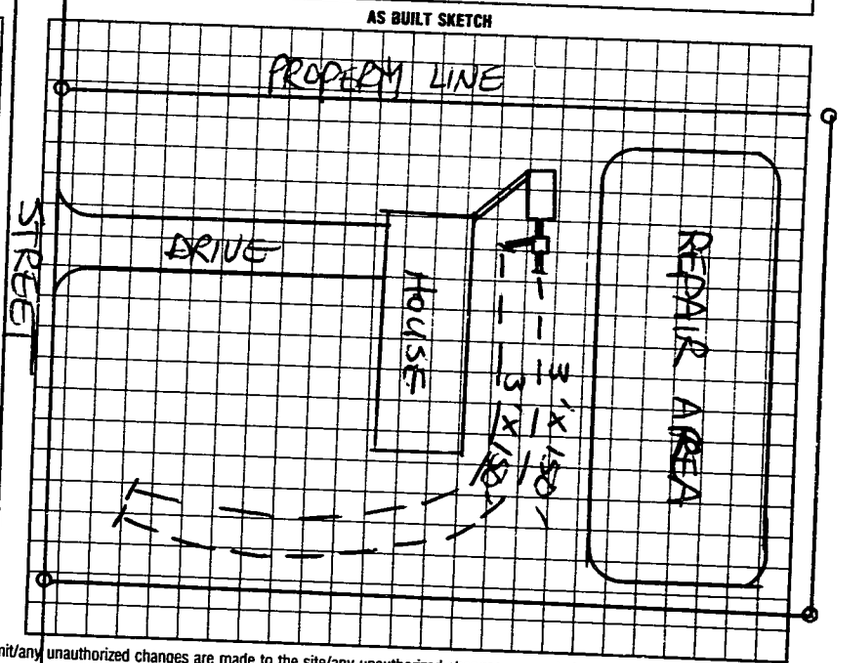

I understand that this permit can be suspended or revoked if any false information is supplied toward securing the permit/any unauthorized changes are made to the site/any unauthorized changes are made in the installation of the system. Improvement Permit is valid for 60 months from date of issuance.

Signed: _____

Improvement Permit by: STEVE BROWN date 8/22/90

Existing System Inspection by: _____ date _____

Installed by: ARNIE DUNCAN

Certificate of Completion by: STEVE HEARICK date 12/1/93

Operation Permit by: _____ date _____

HEALTH DEPT. COPY: WHITE INSPECTION COPY (FINAL): GREEN OWNER COPY (FINAL): YELLOW INSPECTION COPY (INITIAL): PINK OWNER COPY (INITIAL): GOLD