IREDELL COUNTY HEALTH DEPARTMENT

THIS PERMIT VOIDS PREVIOUS ISSUED 12-15-97

STATESVILLE 704-878-5305 MOORESVILLE 704-664-5281

IMPROVEMENT PERMIT / AUTHORIZATION TO CONSTRUCT / OPERATION PERMIT / EXISTING SYSTEM INSPECTION

PERMIT# 070766 PIN# 4738 48 2327 DATE 10-16-00

OWNER OR CONTRACTOR DALLAS EMORY PHONE: Business 876-0552 // 881-0119 Home (716) 386-5954

ADDRESS 5470 CRESTWOOD ROAD, BEMUS POINT, NY 14712

LOCATION NC 115 N, TR S. CHIPLEY FORD, TL RIVER RUN RD, TL BRAMBLEWOOD DRIVE, 2ND LOT ON RIGHT

SUBDIVISION RIVER RUN BLOCK / SECTION II LOT 54 LOT AREA 0.474 ACRE SITE CLASS PS DESIGN FLOW 240 L.T.A.R. 0.30 GPD/FT²

Septic Tank: 1000 Gallons; STB 1072 Date 8.20.00

Pump Tank: _____ Gallons; PT _____ Date _____

Pump Make: _____ Model _____ Serial No. _____

Nitrification Field: No Fields 1 Square Feet EQ. TO 810 Linear Feet 270+

No Lines FOUR Trench Width 36" Max Trench Bottom Depth 36" Depth SAME 6"

☑ New System ☐ Repair System Type: I, II, III, IV, V, VI

System Description: 25% REDUCTION (GRAVITY)

Repair System Description: 50% REDUCTION (PUMP)

Maintenance Agreement Required: ☐ Yes ☑ No

☑ House/Mod. Home ☐ Mobile Home ☐ Business ☐ Other

No. Bedrooms 2 No. Bathrooms 2 No. Employees ____


☐ Slab ☐ Crawl Space ☑ Basement w/plumbing ☐ Basement wo/plumbing

Water Supply: ☐ Individual ☑ Public ☐ Community

Comments/Conditions: INSTALL 25% REDUCTION SYSTEM USING 45 CHAMBERS (AT REQUEST) AS SHOWN OR 27 HDS SECTIONS (8,8,6,5) SCALE: 1" = 40'

Comments/Conditions: ① SYSTEM SIZED FOR TWO BEDROOMS ONLY. ② SEPTIC TANK WITH RISERS AND MARKER INSTALLED USING "Poly Lok" FILTER

INITIAL SITE SKETCH

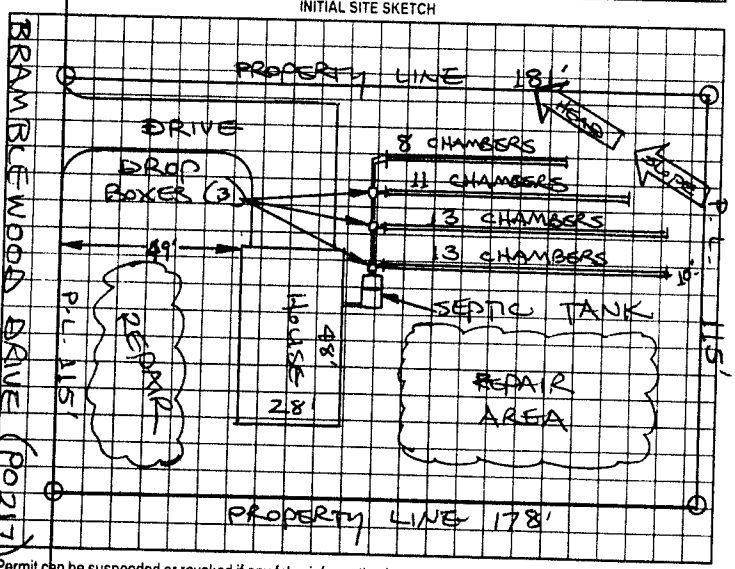

AS BUILT SKETCH

SYSTEM INSTALLED USING 27 HDS SECTIONS (OF 8,8,6,5) ACCORDING TO INITIAL SITE SKETCH

Permit can be suspended or revoked if any false information is supplied toward securing the permit/any unauthorized changes are made to the site/any unauthorized changes are made in the installation of the system. Improvement Permit with plat valid without expiration. Improvement Permit with site plan valid for sixty months. Authorization to Construct is valid for a period equal to that of Improvement Permit – not to exceed sixty months.

Signed: _____ date 10/20/00 Installed by: TOMMY FRYE

Improvement Permit by: STEVE HEDRICK date 10-16-00 Operation Permit by: STEVE HEDRICK date 11-6-00

Authorization to Construct by: STEVE HEDRICK date 10-16-00 Existing System Inspection by: _____ date _____

HEALTH DEPT COPY WHITE OWNER COPY (FINAL) YELLOW OWNER COPY (INITIAL) PINK