IREDELL COUNTY HEALTH DEPARTMENT

STATESVILLE 704-878-5305 MOORESVILLE 704-664-5281

55437

IMPROVEMENT PERMIT / CERTIFICATE OF COMPLETION / OPERATION PERMIT / EXISTING SYSTEM INSPECTION

PROPERTY DESCRIPTION NO. 20792 DATE 4/7/95 TAX MAP NO. 13E-1-A-1

OWNER OR CONTRACTOR HOPE BROTHERS PHONE: Business Home 872-4111 Watershed: ☐ Yes ☐ No WSIIA

ADDRESS 120 BARKLEY ROAD STATESVILLE, NC 28677

LOCATION NC 115 N, TR S. CHIPLEY FORD RD, TL RIVER RUN RD, LOT ON RIGHT AT RIVERBANK RD.

SUBDIVISION RIVER RUN BLOCK / SECTION II LOT 1 LOT AREA 122'x203'x100'x234' SITE CLASS. PS DESIGN FLOW 360 L.T.A.R. 0.35 GPD/FT²

Septic Tank: 1000 Gallons; STB 1012 Date 7/24/95

Pump Tank: _____ Gallons; PT _____ Date _____

Pump Make: _____ Model EQUITONE Serial No. 258

Nitrification Field: No Fields 1 Square Feet 1035 Linear Feet 345

No Lines 5 Trench Width 36" Max Trench Bottom Depth 18-36" Gravel Depth 12"

☒ New System ☐ Repair System Type: I, II, III, IV, V, VI

System Description: CONVENTIONAL GRAVITY

Repair System Description: CONV. GRAVITY

Maintenance Agreement Required: ☐ Yes ☒ No

☐ Slab ☒ Crawl Space ☐ Basement w/plumbing ☐ Basement wo/plumbing

☒ House/Mod. Home No. Bedrooms 3

☐ Mobile Home No. Bathrooms 2

☐ Business No. Employees _____


☐ Other _____

Water Supply:
☒ Individual
☐ Community
☒ Public WELL


Comments: ① KEEP WELL MINIMUM 50 FROM SYSTEM ② INSTALL LINES ON CONTOUR NO DEEPER THAN 36", 9' APART ON CENTER

Comments: 43 CHAMBERS INSTALLED AT BUILDER'S REQUEST

INITIAL SITE SKETCH

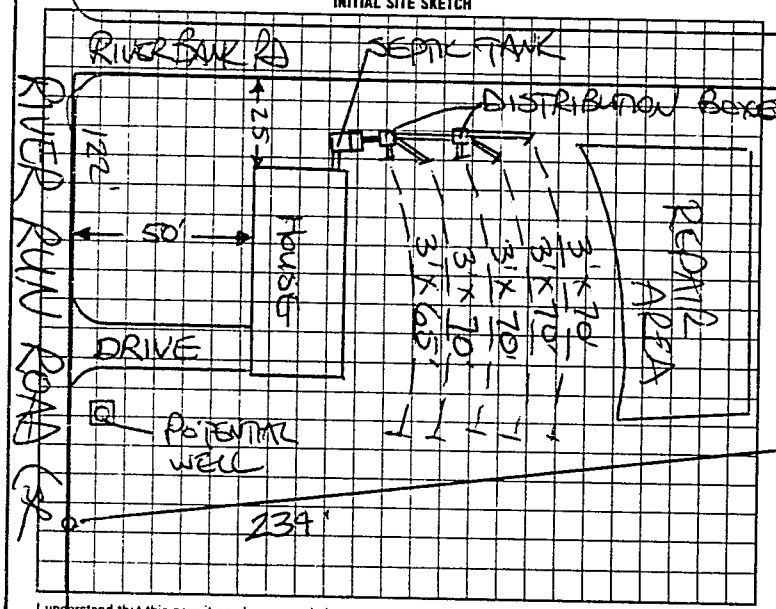

AS BUILT SKETCH

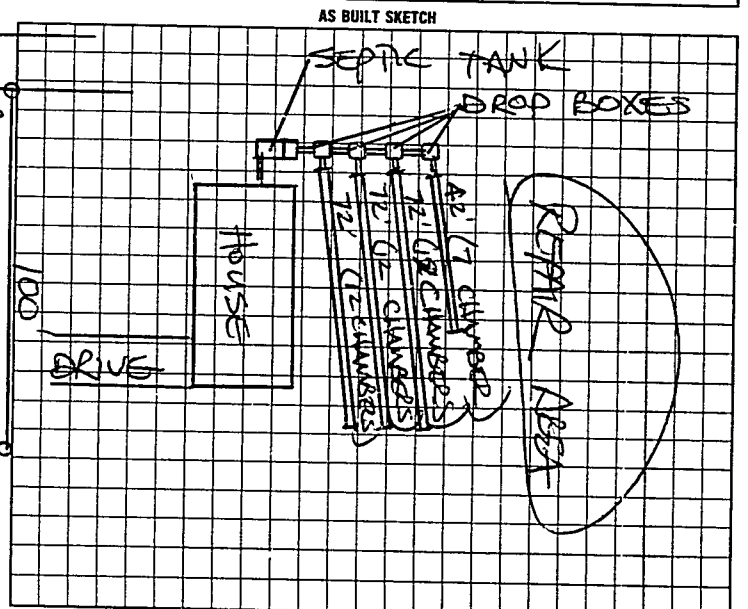

I understand that this permit can be suspended or revoked if any false information is supplied toward securing the permit/any unauthorized changes are made to the site/any unauthorized changes are made in the installation of the system. Improvement Permit is valid for 60 months from date of issuance.

Signed: _____

Improvement Permit by: STEVE HEDRICK date 4/7/95

Existing System Inspection by: _____ date _____

Installed by: ARNIE DUNCAN

[redacted] date _____

Operation Permit by: STEVE HEDRICK date 10/12/95

HEALTH DEPT COPY: WHITE INSPECTION COPY (FINAL): GREEN OWNER COPY (FINAL): YELLOW INSPECTION COPY (INITIAL): PINK OWNER COPY (INITIAL): GOLD

0 1 2 0 0 0