IREDELL COUNTY HEALTH DEPARTMENT

STATESVILLE 704-878-5305 MOORESVILLE 704-664-5281

5543

IMPROVEMENT PERMIT / CERTIFICATE OF COMPLETION / OPERATION PERMIT / EXISTING SYSTEM INSPECTION

PROPERTY DESCRIPTION NO. 20792 DATE 4/7/95 TAX MAP NO. 13E-1-A-1 Watershed: ☐ Yes ☐ No

OWNER OR CONTRACTOR HOPE BROTHERS PHONE: Business Home 872-4111

ADDRESS 1120 BARKLEY ROAD STATESVILLE NC 28677

LOCATION NC 115 N TR S. CHIPLEY FORD RD, T RIVER RUN RD, 1ST RD RIGHT AT RIVER BANK

SUBDIVISION RIVER RUN BLOCK / SECTION II LOT 1 LOT AREA 22+ x 203 x 103 x 234 SITE CLASS PST DESIGN FLOW 360 L.T.A.R. 0.35 GPD

Septic Tank: 1000 Gallons; STB 1012 Date 7/24/95

Pump Tank: Gallons; FT Date

Pump Make: Model EQUINOX Serial No. 258

Nitrification Field: No Fields 1 Square Feet 1035 Linear Feet 345

No Lines 5 Trench Width 36" Ma. Trench Bottom Depth 18-36" Gravel Depth 12"

☐ New System ☐ Repair System Type: I II III IV V VI

System Description: CONVENTIONAL GRAVITY

Repair System Description: CONV. GRAVITY

Maintenance Agreement Required: ☐ Yes ☐ No

☐ Slab ☐ Crawl Space ☐ Basement w/plumbing ☐ Basement w/o plumbing

☐ House/Mod. Home No. Bedrooms 3

☐ Mobile Home No. Bathrooms 2

☐ Business No. Employees

☐ Other

Water Supply:

☐ Individual


☐ Community

☐ Public WELL


Comments: 1) KEEP WELL MINIMUM 50 FROM SYSTEM 2) INSURE LINES ON CONTOUR NO DEEPER THAN 36", 9' APART ON CENTER

Comments: 43 CHAMBERS INSTALLED AT BUILDERS REQUEST

INITIAL SITE SKETCH

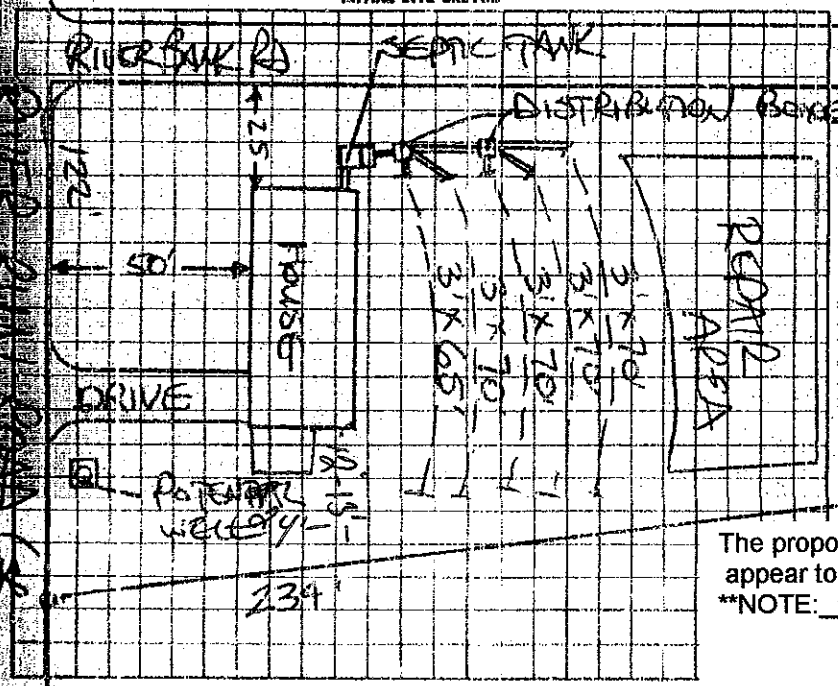

AS BUILT SKETCH

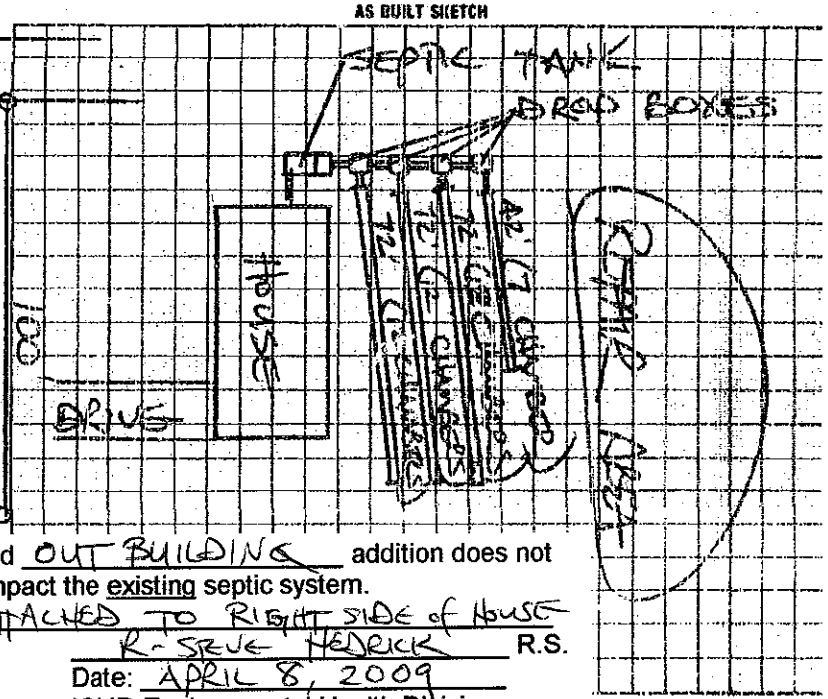

The proposed OUT BUILDING addition does not appear to impact the existing septic system.

**NOTE: ATTACHED TO RIGHT SIDE OF HOUSE

R. STEVE HENDRICK R.S.

Date: APRIL 8, 2009

ICHD-Environmental Health Division

I understand that this permit can be suspended or revoked if any false information is supplied to ... in the installation of the system

Improvement Permit is valid for 60 months from date of issuance.

Signed:

Improvement Permit by: STEVE HENDRICK date 4/9/95

Existing System Inspection by: date

Installed by: ARNIE DUNCAN date

Operation Permit by: STEVE HENDRICK date 12/12/95

HEALTH DEPT. COPY: WHITE INSPECTION COPY (FINAL): GREEN OWNER COPY (FINAL): YELLOW INSPECTION COPY (INITIAL): PINK OWNER COPY (INITIAL): GOLD

4/8/09 Lin Hopper 4738-48-6203 282 River Run Rd - Stat. JAN. 5, 1989 10:18

0 3 4 0 0