IREDELL COUNTY HEALTH DEPARTMENT

STATESVILLE 704-878-5305 MOORESVILLE 704-664-5281

5543

IMPROVEMENT PERMIT / CERTIFICATE OF COMPLETION / OPERATION PERMIT / EXISTING SYSTEM INSPECTION

PROPERTY DESCRIPTION NO. 20792 DATE 4/7/95 TAX MAP NO. 3E-1-A-1 Watershed: ☐ Yes ☐ No

OWNER OR CONTRACTOR HOPE BROTHERS PHONE: Business Home 872-4110

ADDRESS 120 BARKLEY ROAD STATESVILLE, NC 28677

LOCATION NC 115 N TR S. CHIPLEY FORD RD, T RIVER RUN RD, LOT ON RIGHT AT RIVER RUN

SUBDIVISION RIVER RUN BLOCK / SECTION II LOT 1 LOT AREA 22,203 / 100 x 234 SITE CLASS PS DESIGN FLOW 360 L.T.A.R. 0.35 GPD

Septic Tank: 1000 Gallons; STB 1012 Date 7/24/95

Pump Tank: ____ Gallons; FT ____ Date ____

Pump Make: ____ Model EQUITEK Serial No. 258

Nitrification Field: No. Fields 1 Square Feet 1035 Linear Feet 345

No. Lines 5 Trench Width 36" Max. Trench Bottom Depth 18-36" Gravel Depth 12"

☐ New System ☐ Repair ☐ System Type: I II III IV V VI

System Description: CONVENTIONAL GRAVITY

Repair System Description: CONV. GRAVITY

Maintenance Agreement Required: ☐ Yes ☐ No

☐ Slab ☐ Crawl Space ☐ Basement w/plumbing ☐ Basement w/o/plumbing

☐ House/Mod. Home No. Bedrooms 3

☐ Mobile Home No. Bathrooms 2

☐ Business No. Employees ____


☐ Other ____

Water Supply: ☒ Individual ☐ Community ☐ Public WELL


Comments: (1) KEEP WELL MINIMUM 50 FROM SYSTEM (2) INSTALL LINES ON CONTOUR NO DEEPER THAN 36", 9' APART ON CENTER

Comments: 43 CHAMBERS INSTALLED PER BUILDER'S REQUEST

INITIAL SITE SKETCH

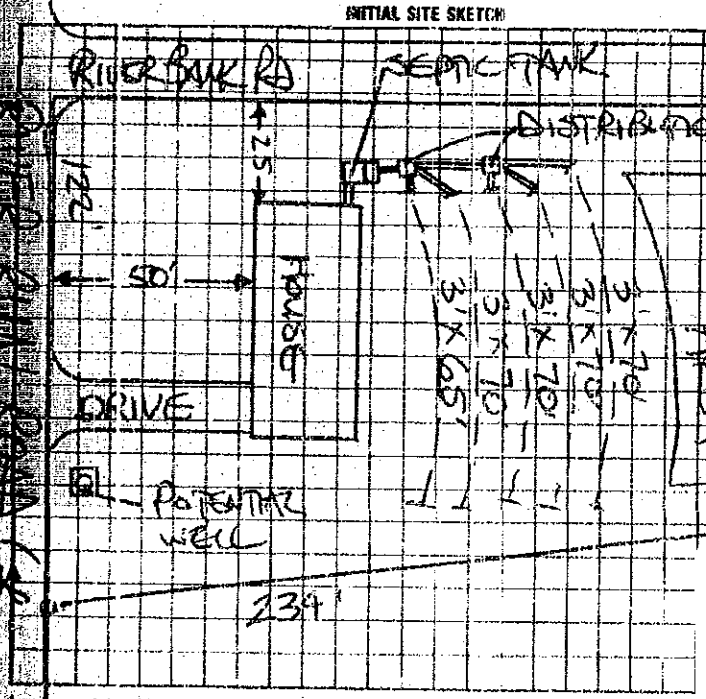

AS BUILT SKETCH

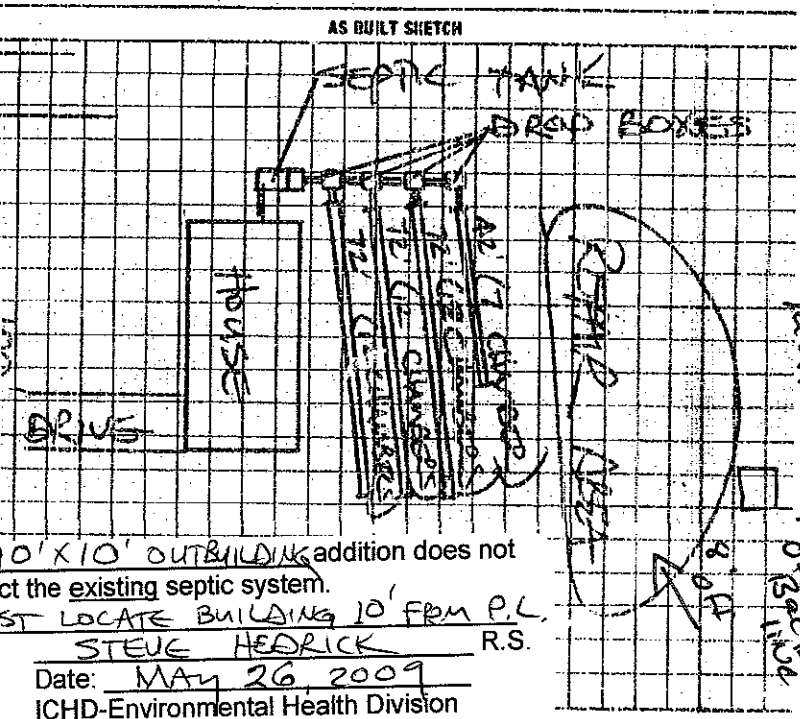

The proposed 10'X10' OUTBUILDING addition does not appear to impact the existing septic system.

**NOTE: MUST LOCATE BUILDING 10' FROM P.L.

STEVE HEDRICK R.S.

Date: MAY 26, 2009

ICHD-Environmental Health Division

I understand that this permit can be suspended or revoked if any false information is supplied to Improvement Permit is valid for 60 months from date of issuance.

Signed: ____

Improvement Permit by: STEVE HEDRICK date 4/9/95

Existing System Inspection by: ____ date ____

Installed by: ARNIE DUNCAN

Operation Permit by: STEVE HEDRICK date 12/12/95

HEALTH DEPT. COPY, WHITE INSPECTION COPY (FINAL), GREEN OWNER COPY (FINAL), YELLOW INSPECTION COPY (INITIAL), PINK OWNER COPY (INITIAL), GOLD

JAN. 5, 1989 18:01