IREDELL COUNTY HEALTH DEPARTMENT

STATESVILLE 704-878-5305 MOORESVILLE 704-664-5281

IMPROVEMENT PERMIT / AUTHORIZATION TO CONSTRUCT / OPERATION PERMIT / EXISTING SYSTEM INSPECTION

PERMIT# 073344 PIN# 4738 48 6972 DATE 7-30-98

OWNER OR CONTRACTOR HOPE BROTHERS PHONE: Business 872-4111 Home

ADDRESS 1120 PARKLEY ROAD, STATESVILLE, NC 28625

LOCATION NC 115 N TR S. CHAPEL FORD, TL RIVER RUN ROAD, TR S. YADKIN RIVER ROAD, 1ST LOT ON LEFT

SUBDIVISION RIVER RUN BLOCK / SECTION II LOT 51 LOT AREA 0.500 ACRE SITE CLASS PS DESIGN FLOW 360 L.T.A.R. 0.30 GPD/FT²

Septic Tank: 1000 Gallons; STB 1012 Date 7-23-99
Pump Tank: Gallons; PT Date
Pump Make: Model Serial No.
Nitrification Field: No Fields 1 Square Feet EQ. TO 1200 Linear Feet 300'
No Lines FOUR Trench Width 36" Max Trench Bottom Depth 36"

☑ New System ☐ Repair System Type: I. II. III. IV. V. VI
System Description: 25% REDUCTION - GRAVITY
Repair System Description: LOW PRESSURE PIPE
Maintenance Agreement Required: ☐ Yes ☑ No
Gravel Depth SAND 6" ☐ Slab ☐ Crawl Space ☑ Basement w/plumbing ☐ Basement wo/plumbing


☑ House/Mod. Home No. Bedrooms 3
☐ Mobile Home No. Bathrooms 2
☐ Business No. Employees
☐ Other

Water Supply: ☐ Individual ☑ Public ☐ Community


Comments/Conditions: INSTALL FIFTY CHAMBERS OR THIRTY HDS SECTIONS IN FOUR LINES ON CONTOUR USING DROP BOXES FOR SERIAL DISTRIBUTION

Comments/Conditions: SEPTIC TANK W/ RISERS INSTALLED USING "POLYLOK" FILTER

INITIAL SITE SKETCH SCALE: 1" = 50'

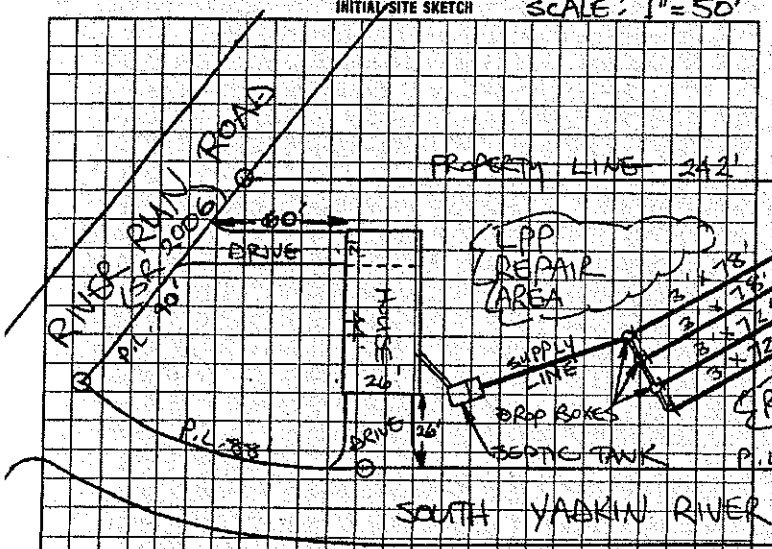

AS BUILT SKETCH

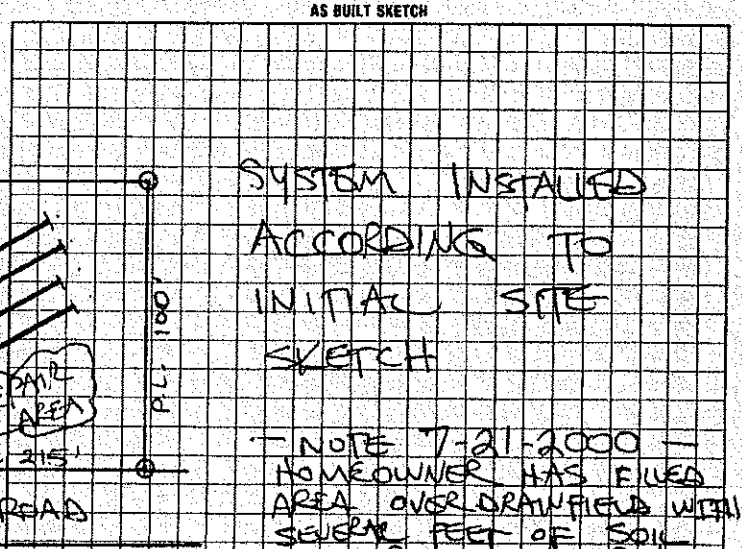

SYSTEM INSTALLED ACCORDING TO INITIAL SITE SKETCH

— NOTE 7-21-2000 — HOMEOWNER HAS FILLED AREA OVER DRAINFIELD WITH SEVERAL FEET OF SOIL AND ROCK — RSH

I understand that this permit can be suspended or revoked if any false information is supplied toward securing the permit/any unauthorized changes are made to the site/any unauthorized changes are made in the installation of the system. Improvement Permit with plat valid without expiration. Improvement Permit with site plan valid for sixty months. Authorization to Construct is valid for a period equal to that of Improvement Permit – not to exceed sixty months.

Signed: _____ date 8-20-98 Installed by: ARNIE DUNCAN

Improvement Permit by: STEVE HEDRICK date 7-30-98 Operation Permit by: STEVE HEDRICK date 3-7-00

Authorization to Construct by: STEVE HEDRICK date 7-30-98 Existing System Inspection by: _____ date _____

HEALTH DEPT. COPY: WHITE INSPECTION COPY (FINAL): GREEN OWNER COPY (FINAL): YELLOW INSPECTION COPY (INITIAL): PINK OWNER COPY (INITIAL): GOLD