IREDELL COUNTY HEALTH DEPARTMENT

STATESVILLE 704-878-5305 MOORESVILLE 704-664-5281

IMPROVEMENT PERMIT / AUTHORIZATION TO CONSTRUCT / OPERATION PERMIT / EXISTING SYSTEM INSPECTION

PERMIT# 073706 PIN# 4738 48 8596 DATE 5-19-98

OWNER OR CONTRACTOR Hope Brothers PHONE: Business Home 872-4111

ADDRESS 1120 Barkley Road, Statesville, NC 28677

LOCATION NC 115 N, TR S. Chipley Ford, TL River Run Road, TR Riverbank Road, 4th Lot on Left

SUBDIVISION River Run BLOCK / SECTION II LOT 24 LOT AREA 100 X 220+/- SITE CLASS PS DESIGN FLOW 360 L.T.A.R. 0.30 GPD/FT²

Septic Tank: 1000 Gallons; STB 1012 Date 5-1-99
Pump Tank: 1000 Gallons; PT 17 Date 3-29-99
Pump Make: Goulds Model WS05118 Serial No C9943755
Nitrification Field: No Fields 1 Square Feet Eq. To 1200 Linear Feet 300+
No Lines Five Trench Width 36" Max Trench Bottom Depth 36" ~~Grade~~ Depth SAME

[X] New System [ ] Repair System Type: I, II, III, IV, V, VI
System Description: Chambered + Pump
Repair System Description: PPBPS + Pump
Maintenance Agreement Required: [ ] Yes [X] No
[ ] Slab [X] Crawl Space [ ] Basement w/plumbing [ ] Basement wo/plumbing


[X] House/Mod. Home No. Bedrooms 3
[ ] Mobile Home No. Bathrooms 2
[ ] Business No. Employees
[ ] Other

Water Supply: ☐ Individual ☒ Public ☐ Community


Comments:/Conditions: ① INSTALL FIFTY CHAMBERS IN FIVE EQUAL LENGTH LINES ON CONTOUR AS SHOWN. ② SEE ATTACHED SHEETS FOR PUMP & PRESSURE MANIFOLD REQUIREMENTS.

Comments:/Conditions ① SEPTIC TANK WITH RISERS INSTALLED USING "POLYLOK" FILTER ② TANKS AND DRAINFIELD INSPECTED 7-30-99 (RSH) AS SHOWN BELOW

INITIAL SITE SKETCH

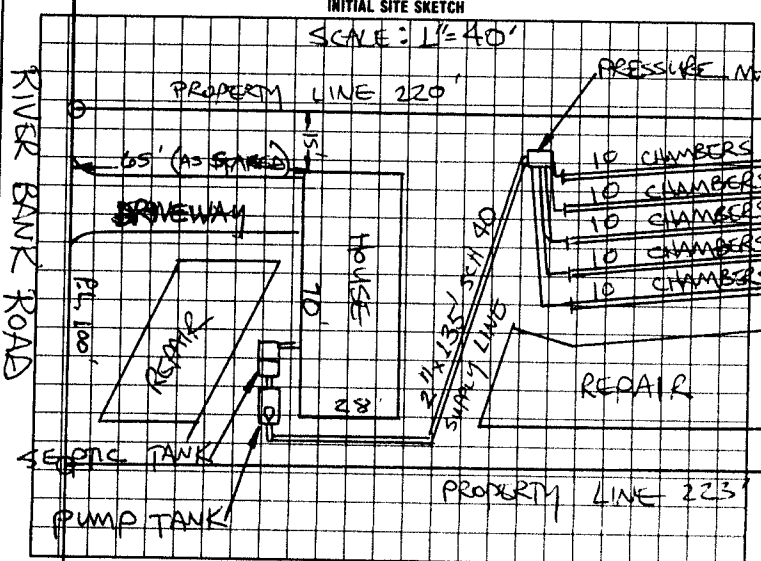

AS BUILT SKETCH

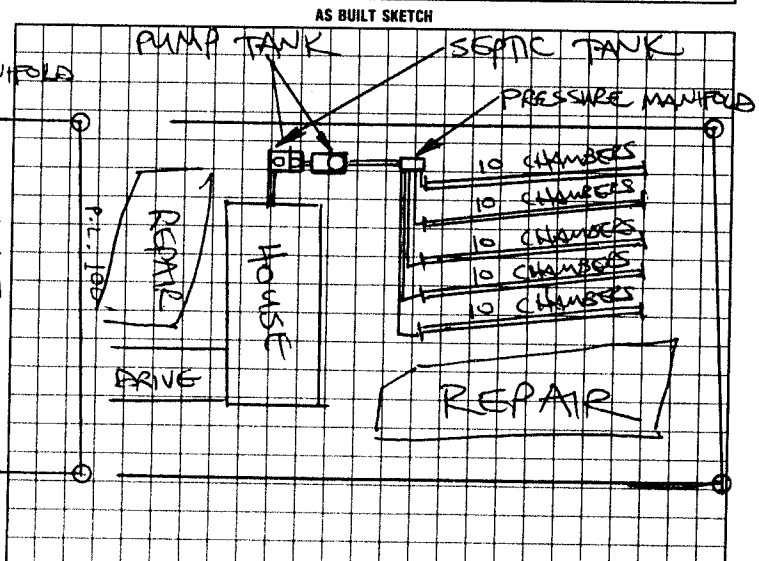

I understand that this permit can be suspended or revoked if any false information is supplied toward securing the permit/any unauthorized changes are made to the site/any unauthorized changes are made in the installation of the system. Improvement Permit with plat valid without expiration. Improvement Permit with site plan valid for sixty months. Authorization to Construct is valid for a period equal to that of Improvement Permit – not to exceed sixty months.

Signed: Jim A. Hope date 5-20-98 Installed by: ARNIE DUNCAN

Improvement Permit by: STEVE HEDRICK date 5-19-98 Operation Permit by: STEVE HEDRICK date 10-12-99

Authorization to Construct by: STEVE HEDRICK date 5-19-98 Existing System Inspection by: date

HEALTH DEPT. COPY: WHITE INSPECTION COPY (FINAL) GREEN OWNER COPY (FINAL) YELLOW INSPECTION COPY (INITIAL) PINK OWNER COPY (INITIAL) GOLD