# IREDELL COUNTY HEALTH DEPARTMENT

Statesville Office (704) 878-5305 Mooresville Office (704) 660-3625

## IMPROVEMENT PERMIT / AUTHORIZATION TO CONSTRUCT / OPERATION PERMIT / EXISTING SYSTEM

PERMIT # 20187

PIN # 4738499007

APPLICANT: Curtis Riblin

APPLICANT ADDRESS: 819 Phillips Ln Statesville NC

SITE ADDRESS: 121 S. Yadkin River Rd Statesville NC

PHONE: 704-239-3693 ALT. PHONE: N/A

SITE DIRECTIONS: 115 N (R) on S Chipley Ford Rd (L) on River Run Rd (R) on S Yadkin River Rd

SUBDIVISION: River Run II SECTION: S3 P1 LOT # 50+49 LOT AREA: 1ac

DESIGN FLOW: 360 L.T.A.R.: .3

Septic Tank 1000 (gal) STB 760 Date 10-6-13

Pump Tank N/A (gal) PT N/A Date N/A

Pump Make N/A Model Poly Flo Serial # PL-68

# Nitrification Fields 1 # Lines 3 Linear Ft: 300

Trench Width 36" Max. Trench Bottom Depth 36" Gravel Depth N/A

[X] New System [ ] Repair [ ] Expansion System Type: I (II) III IV V VI

System Description: 25% Reduction

Repair System Description: 25% Reduction

Maintenance Agreement Required: [ ] YES [X] NO

[X] GRAVITY [ ] PRESSURE

[X] Residence [ ] Business [ ] Other [ ] Slab [ ] Basement w/plumbing


No. Bedrooms 3 No. Persons 6 No. Employees ___ [X] Crawl Space

[ ] Basement w/o plumbing

Water Supply: [ ] Private [X] Public [ ] Community

Comments / Conditions: * Improvement permit only * Need new plat with combined lots. Rock water line 10' from any part of STS. No grading or fill in the Septic or repair area.

INITIAL SITE SKETCH

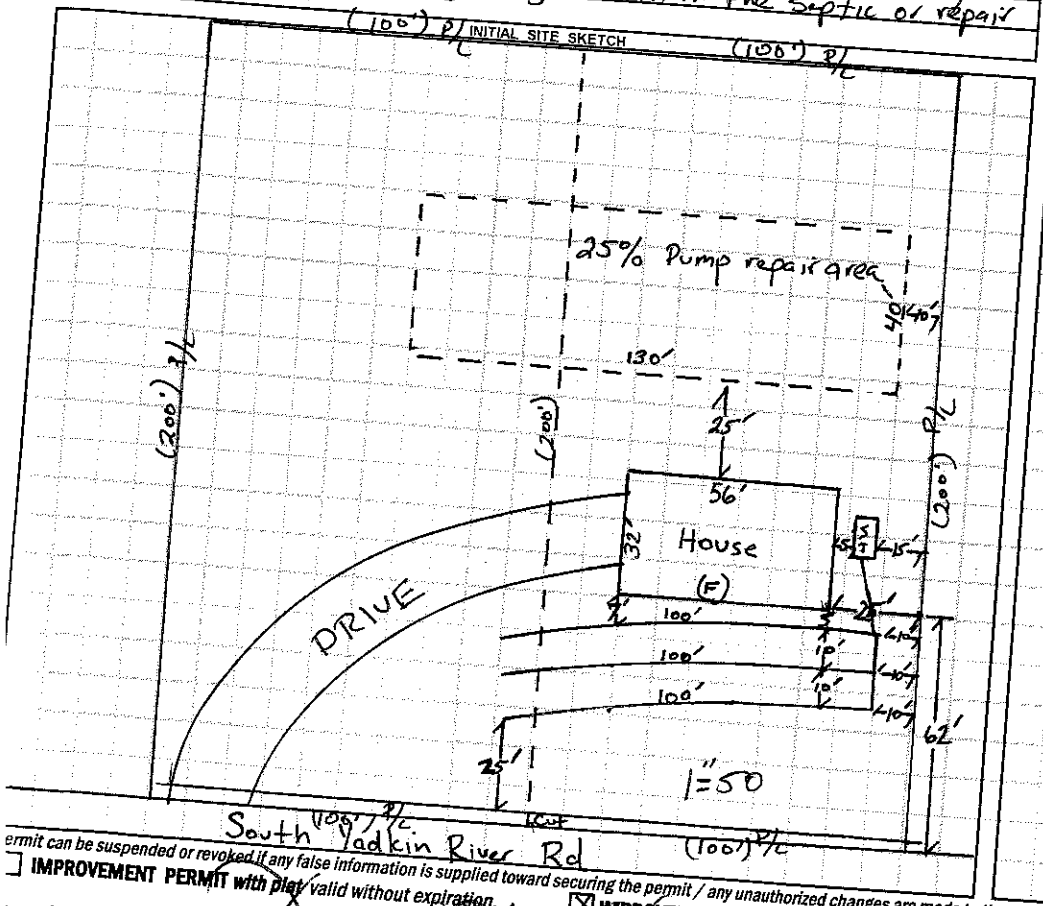


AS BUILT SKETCH

Installed Arc 36 as designed

permit can be suspended or revoked if any false information is supplied toward securing the permit / any unauthorized changes are made to the site / any unauthorized changes are made in the installation of the system. CONTACT A LOCATOR SERVICE PRIOR TO ANY EXCAVATION

[ ] IMPROVEMENT PERMIT with plat valid without expiration. [X] IMPROVEMENT PERMIT with site plan valid for 60 mos. [X] AUTHORIZATION TO CONSTRUCT valid for period equal to IMPROVEMENT PERMIT--not to exceed 60 mo.

Owner / Applicant Signature: Debra Abee Debra Abee Date: 2/5/14 3/3/14 Installed by: Abee Grading

IMPROVEMENT PERMIT by: Robert H. Lee Date: 02/04/14 OPERATION PERMIT by: Robert H. Lee Date: 04/14/14

AUTHORIZATION TO CONSTRUCT by: Robert H. Lee Date: 02/28/14 Existing System Inspected by: Date:

Health Dept. Copy - WHITE Applicant (Final Approval) - YELLOW Applicant (Conditional Approval) - PINK