IREDELL COUNTY HEALTH DEPARTMENT

THIS PERMIT VOIDS PREVIOUS ISSUED 10/16/90 55416

STATESVILLE 704-878-5305 MOORESVILLE 704-664-5281

IMPROVEMENT PERMIT / CERTIFICATE OF COMPLETION / OPERATION PERMIT / EXISTING SYSTEM INSPECTION

PROPERTY DESCRIPTION NO. 12075 DATE 2/22/95 TAX MAP NO. PART OF 13E-A-9 Watershed: ☐ Yes ☒ No

OWNER OR CONTRACTOR J. L. HOPE PHONE: Business 872-4111 Home

ADDRESS

LOCATION NC 115 N, TR S, CHIPLEY FORD, TL RIVER RUN ROAD, 0.3 MILE ON LEFT, OFF ROAD ~550'

SUBDIVISION RIVER RUN BLOCK / SECTION LOT 1 LOT AREA 3.8538 Ac. SITE CLASS. PS DESIGN FLOW 360 L.T.A.R. 0.35 GPD/FT²

Septic Tank: 1000 Gallons; STB 10/2 Date 2-1-95

Pump Tank: Gallons; PT Date

Pump Make: Model EQUIVALENT Serial No.

Nitrification Field: No Fields 1 Square Feet TO 1035 Linear Feet 258

No Lines 2 Trench Width 36" Max Trench Bottom Depth 36" Gravel Depth N/A

☒ New System ☐ Repair System Type: I, II, III, IV, V, VI

System Description: GRAVITY FED CHAMBERS

Repair System Description: CONV/CHAMBER/CONV

Maintenance Agreement Required: ☐ Yes ☒ No

☒ House/Mod. Home No. Bedrooms 3

☐ Mobile Home No. Bathrooms 2

☐ Business No. Employees

☐ Other


☐ Slab ☐ Crawl Space ☒ Basement w/plumbing ☐ Basement wo/plumbing

Water Supply: ☒ Individual ☐ Community ☐ Public WELL

Comments: ① CHAMBERED SYSTEM INSTALLED AT REQUEST ② KEEP SYSTEM MINIMUM 15' FROM BASEMENT DRAIN 100' FROM WELL ③ INSTALL LINES AS SHOWN, NO DEEPER THAN 36", 9' APART MIN. ON CENTER

Comments:

INITIAL SITE SKETCH

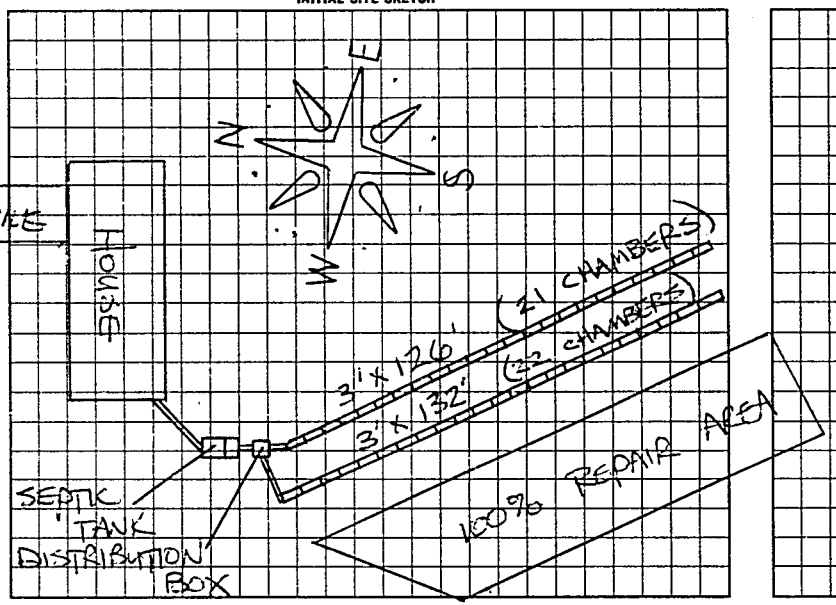

AS BUILT SKETCH

SYSTEM INSTALLED ACCORDING TO INITIAL SITE SKETCH

I understand that this permit can be suspended or revoked if any false information is supplied toward securing the permit/any unauthorized changes are made to the site/any unauthorized changes are made in the installation of the system. Improvement Permit is valid for 60 months from date of issuance.

Signed:

Improvement Permit by: STEVE HEDRICK date 2/22/95

Existing System Inspection by: date

Installed by: ARNIE DUNCAN

Certificate of Completion by: STEVE HEDRICK date 7-14-95

Operation Permit by: date

HEALTH DEPT. COPY: WHITE INSPECTION COPY (FINAL): GREEN OWNER COPY (FINAL): YELLOW INSPECTION COPY (INITIAL): PINK OWNER COPY (INITIAL): GOLD

E 17000