IREDELL COUNTY HEALTH DEPARTMENT

STATESVILLE 704-878-5305 MOORESVILLE 704-664-5281

IMPROVEMENT PERMIT / AUTHORIZATION TO CONSTRUCT / OPERATION PERMIT / EXISTING SYSTEM INSPECTION

PERMIT# 093813 PIN# 4738 58 1677 DATE 1-27-01

OWNER OR CONTRACTOR JONATHAN S. HOPE PHONE: Business Home 876-3413

ADDRESS 139 BRAMBLEWOOD DR, STATESVILLE, NC 28625

LOCATION NC115 N, TR S. CHIPLEY FORD, TL RIVER RUN RD, TR RIVERBANK RD, LOT ON LEFT BEFORE END

SUBDIVISION RIVER RUN BLOCK / SECTION II LOT 21 LOT AREA 0.53 ACRES SITE CLASS PS DESIGN FLOW 360 L.T.A.R. 0.40 GPD/FT²

Septic Tank: 1000 Gallons; STB 825 Date 3-7-01

Pump Tank: Gallons; PT Date

Pump Make: Model Serial No.

Nitrification Field: No Fields 1 Square Feet EQ. to 900 Linear Feet 228

No Lines FOUR Trench Width 36" Max Trench Bottom Depth 36" Gravel Depth STND 6"

☑ New System ☐ Repair System Type: I II III IV V VI

System Description: 25% REDUCTION GRAVITY

Repair System Description: 50% REDUCTION GRAVITY

Maintenance Agreement Required: ☐ Yes ☑ No

☑ House/Mod. Home ☐ Mobile Home ☐ Business ☐ Other

No. Bedrooms 3 No. Bathrooms 2 No. Employees


☐ Slab ☑ Crawl Space ☐ Basement w/plumbing ☐ Basement wo/plumbing

Water Supply: ☐ Individual ☑ Public ☐ Community


Comments/Conditions: INSTALL THIRTY EIGHT (38) CHAMBERS OR TWENTY THREE (23) HDS SECTIONS ON CONTOUR AS FLAGGED

Comments/Conditions: SEPTIC TANK WITH MARKER INSTALLED USING "POLYLOK" FILTER

INITIAL SITE SKETCH

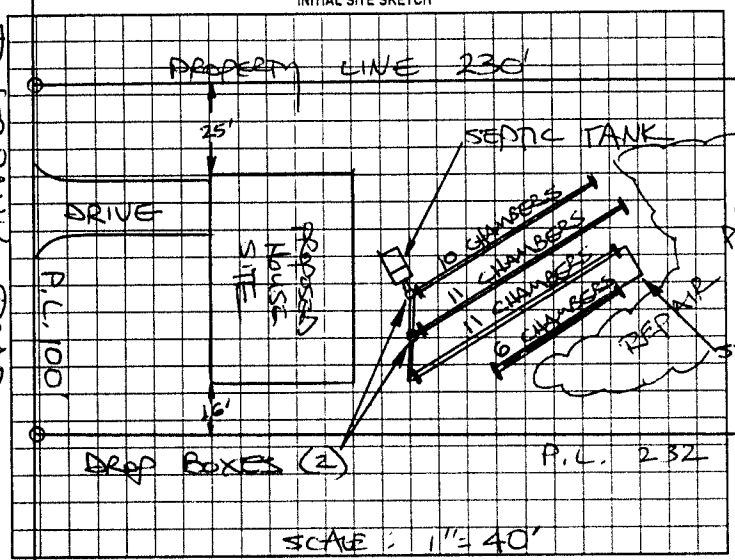

AS BUILT SKETCH

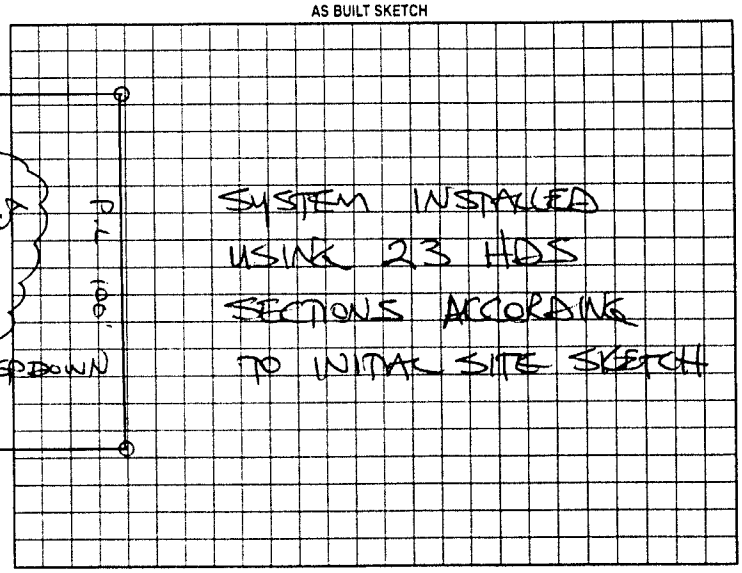

RIVERBANK ROAD

Permit can be suspended or revoked if any false information is supplied toward securing the permit/any unauthorized changes are made to the site/any unauthorized changes are made in the installation of the system. Improvement Permit with plat valid without expiration. Improvement Permit with site plan valid for sixty months. Authorization to Construct is valid for a period equal to that of Improvement Permit – not to exceed sixty months.

Signed: Jonathan S. Hope date 1-27-01 Installed by: UPRIGHT GRADING

Improvement Permit by: STEVE HEDRICK date 1-27-01 Operation Permit by: STEVE HEDRICK date 7-18-01

Authorization to Construct by: STEVE HEDRICK date 1-27-01 Existing System Inspection by: date

HEALTH DEPT COPY WHITE OWNER COPY (FINAL) YELLOW OWNER COPY (INITIAL) PINK