IREDELL COUNTY HEALTH DEPARTMENT

Statesville Office (704) 878-5305 Mooresville Office (704) 660-3625 PERMIT # 179498

IMPROVEMENT PERMIT / AUTHORIZATION TO CONSTRUCT / OPERATION PERMIT / EXISTING SYSTEM

PIN # 4738581809

APPLICANT: Clayton Homes - Concver APPLICANT ADDRESS: 1230 Concver Blvd West

SITE ADDRESS: 126 South Yadkin River Rd PHONE: 828-465-3450 ALT. PHONE:

SITE DIRECTIONS: Hwy 115 (R) on Chipley Ford, (L) on River Run, (R) on S Yadkin River Rd, Lot on (R)

SUBDIVISION: River Run 2 SECTION: LOT # 35 LOT AREA: .51 Ac DESIGN FLOW: 360 L.T.A.R.: .3

Septic Tank 1000 (gal) STB 760 Shaft Date 3-18-13
Pump Tank (gal) PT Date
Pump Make Model Serial #
Nitrification Fields 1 # Lines 4 Linear Ft: (300) 75 each
Trench Width 36 Max. Trench Bottom Depth 36 Gravel Depth n/a

☒ New System ☐ Repair ☐ Expansion System Type: I II (III) IV V VI
System Description: 25% Reduction Gravity
Repair System Description: 50% Reduction LPP
Maintenance Agreement Required: ☐ YES ☒ NO
☒ GRAVITY ☐ PRESSURE


☒ Residence No. Bedrooms 3
☐ Business No. Persons
☐ Other No. Employees
☐ Slab ☒ Crawl Space
☐ Basement w/plumbing ☐ Basement w/o plumbing

Water Supply: ☐ Private ☒ Public ☐ Community

Comments / Conditions:

IQ4W Installed

INITIAL SITE SKETCH

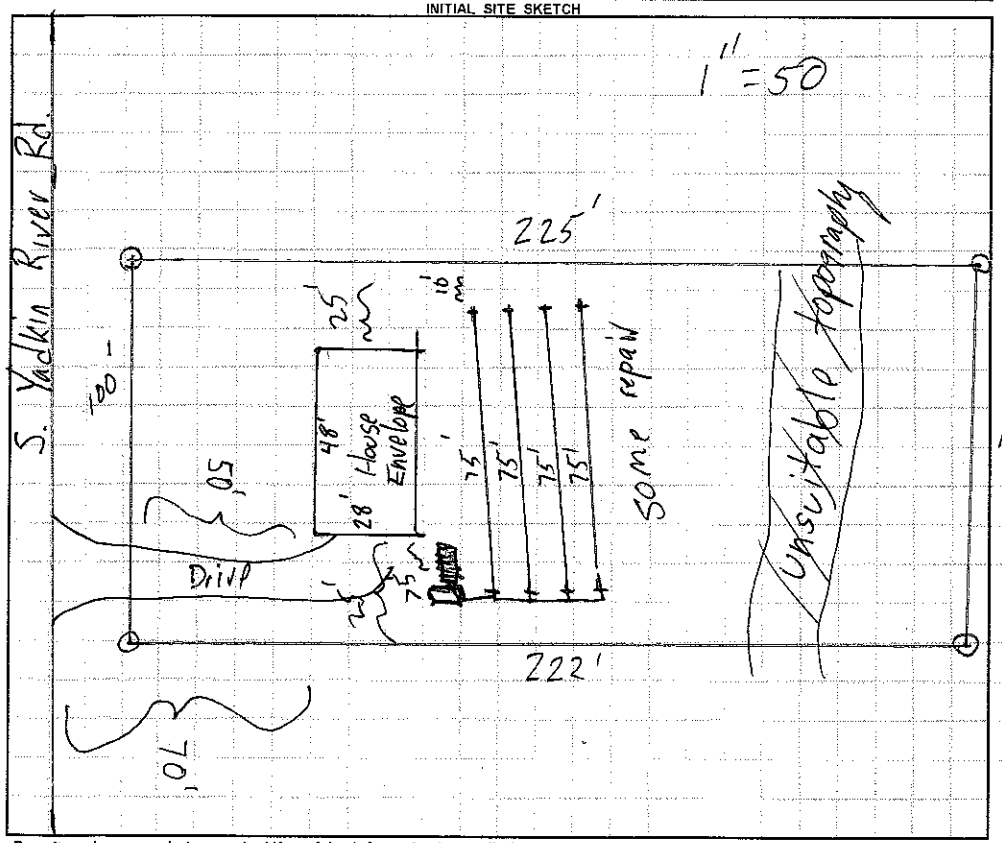

AS BUILT SKETCH

Substantially as shown on initial site sketch

Permit can be suspended or revoked if any false information is supplied toward securing the permit / any unauthorized changes are made to the site / any unauthorized changes are made in the installation of the system. **CONTACT A LOCATOR SERVICE PRIOR TO ANY EXCAVATION**

☐ **IMPROVEMENT PERMIT** *with plat valid without expiration.* ☒ **IMPROVEMENT PERMIT** *with site plan valid for 60 mos.* ☒ **AUTHORIZATION TO CONSTRUCT** *valid for period equal to IMPROVEMENT PERMIT--not to exceed 60 mo.*

Owner / Applicant Signature: Date: 7-12-13 Installed by: A-1 Backhoe

IMPROVEMENT PERMIT by: Date: 7-12-13 OPERATION PERMIT by: Date: 7-23-13

AUTHORIZATION TO CONSTRUCT by: Date: 7-12-13 Existing System Inspected by: Date:

Health Dept. Copy - WHITE Applicant (Final Approval) - YELLOW Applicant (Conditional Approval) - PINK