IREDELL COUNTY HEALTH DEPARTMENT

STATESVILLE 704-878-5305 MOORESVILLE 704-664-5281

IMPROVEMENT PERMIT / AUTHORIZATION TO CONSTRUCT / OPERATION PERMIT / EXISTING SYSTEM INSPECTION

PERMIT# 095251 PIN# 4738 58 2995 DATE 4-9-01

OWNER OR CONTRACTOR KEVIN Hope PHONE: Business (704) 592-4866 Home

ADDRESS 117 BROOKHAVEN ROAD STATESVILLE NC 28625

LOCATION NC 115 N, TR S. CHAREY FORD, TL RIVER RUN, TR S. YADKIN RIVER RD LOT #37 on RIGHT

SUBDIVISION RIVER RUN BLOCK / SECTION II LOT 37 LOT AREA 0.54 ACRE SITE CLASS PS DESIGN FLOW 360 L.T.A.R. 0.30 GPD/FT²

Septic Tank: 1000 Gallons; STB 825 Date 3-6-01
Pump Tank: ____ Gallons; PT ____ Date ____
Pump Make: ____ Model ____ Serial No. ____
Nitrification Field: No Fields 1 Square Feet 90 TO 120 Linear Feet 300+
No Lines FIVE Trench Width 36" Max Trench Bottom Depth 30
Gravel Depth N/A

☒ New System ☐ Repair System Type: I, II, (III), IV, V, VI
System Description: 25% REDUCTION GRAVITY
Repair System Description: 50% REDUCTION GRAVITY
Maintenance Agreement Required: ☐ Yes ☒ No
☐ Slab ☒ Crawl Space ☐ Basement w/plumbing ☐ Basement wo/plumbing


☒ House/Mod. Home No. Bedrooms 3
☐ Mobile Home No. Bathrooms 2
☐ Business No. Employees ____
☐ Other ____

Water Supply: ☐ Individual ☒ Public ☐ Community


Comments/Conditions: INSTALL 25% REDUCTION SYSTEM USING FIFTY (50) CHAMBERS (AT REQUEST), INSTALLED NO DEEPER THAN 30 INCHES.

Comments/Conditions: SEPTIC TANK WITH RISERS INSTALLED USING "POLYLOK" FILTER

INITIAL SITE SKETCH

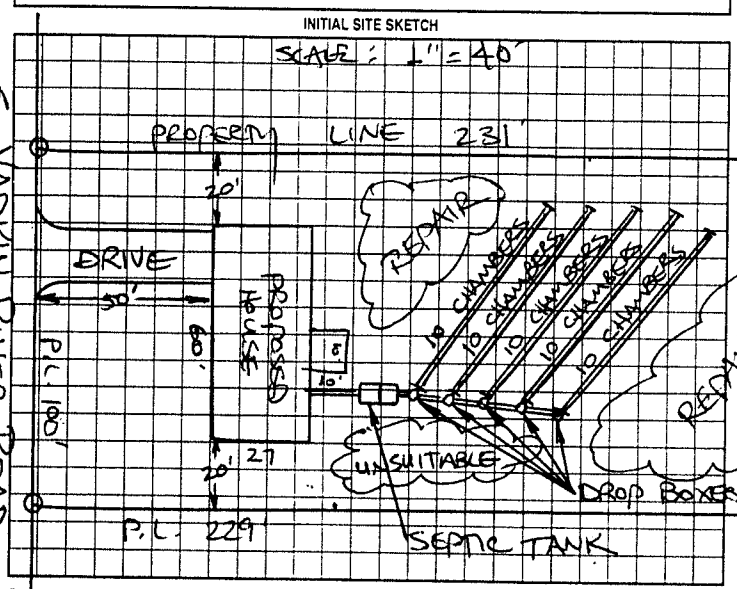

AS BUILT SKETCH

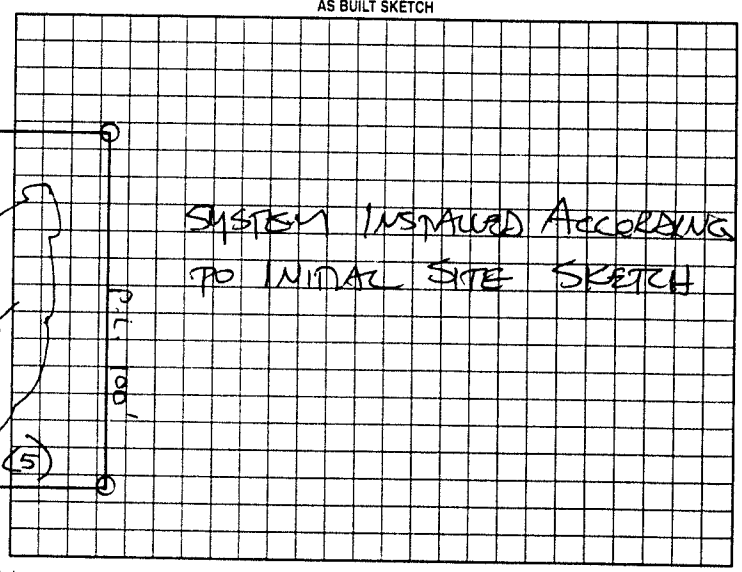

S. YADKIN RIVER ROAD

Permit can be suspended or revoked if any false information is supplied toward securing the permit/any unauthorized changes are made to the site/any unauthorized changes are made in the installation of the system. Improvement Permit with plat valid without expiration. Improvement Permit with site plan valid for sixty months. Authorization to Construct is valid for a period equal to that of Improvement Permit – not to exceed sixty months.

Signed: + Kevin Hope date 4-10-01

Improvement Permit by: STEVE HEDRICK date 4-9-01

Authorization to Construct by: STEVE HEDRICK date 4-9-01

Installed by: STATESVILLE BACKHOE

Operation Permit by: STEVE HEDRICK date 8-22-01

Existing System Inspection by: ____ date ____

HEALTH DEPT. COPY WHITE OWNER COPY (FINAL) YELLOW OWNER COPY (INITIAL) PINK