IREDELL COUNTY HEALTH DEPARTMENT

THIS PERMIT REPLACES PREVIOUS ISSUED 2-3-03

STATESVILLE 704-878-5305 (C) MOORESVILLE 704-664-5281

IMPROVEMENT PERMIT / AUTHORIZATION TO CONSTRUCT / OPERATION PERMIT / EXISTING SYSTEM INSPECTION

PERMIT# 111014 PIN# ~~4738-58-5592~~ (9)-4738583445 (10)4738584427 DATE 3-28-03

OWNER OR CONTRACTOR JUDITH RIGGS PHONE: Business Home 704-873-7881

ADDRESS 146 RIVER BANK ROAD, STATESVILLE, NC 28625

LOCATION NC 115 N, TR S. CHIPLEY FORD RD, TL RIVER ~~RUN~~ RD, TR RIVER BANK RD, LOTS AT END ON RIGHT

SUBDIVISION RIVER RUN BLOCK / SECTION IV LOT ~~9~~ 10 & ~~11~~ LOT AREA 0.92 ACRE SITE CLASS. PS DESIGN FLOW 360 L.T.A.R. 0.35 GPD/FT²

Septic Tank: 1000 Gallons; STB 1012 Date 7-31-04

Pump Tank: _____ Gallons; PT _____ Date _____

Pump Make: _____ Model _____ Serial No. _____

Nitrification Field: No Fields 1 Square Feet _____ Linear Feet 345

No Lines SIX Trench Width 36" Max Trench Bottom Depth 36" Gravel Depth 12"

☒ New System ☐ Repair System Type: I (II) III, IV, V, VI

System Description: CONVENTIONAL, GRAVITY

Repair System Description: 50% REDUCTION, LOW PRESSURE

Maintenance Agreement Required: ☐ Yes ☒ No

☒ House/Mod. Home No. Bedrooms 3

☐ Mobile Home No. Bathrooms 2

☐ Business No. Employees _____

☐ Other _____


☐ Slab ☒ Crawl Space ☐ Basement w/plumbing ☐ Basement wo/plumbing

Water Supply: ☐ Individual ☒ Public ☐ Community

Comments/Conditions: LOTS #10 & 11 TO BE COMBINED USE ONE FLOW DIVIDER TEE TO ACHIEVE EQUAL DISTRIBUTION INTO TWO SETS OF DROP BOXES

Comments/Conditions: SEPTIC TANK WITH MARKER INSTALLED USING "TUFFITE" FILTER

INITIAL SITE SKETCH

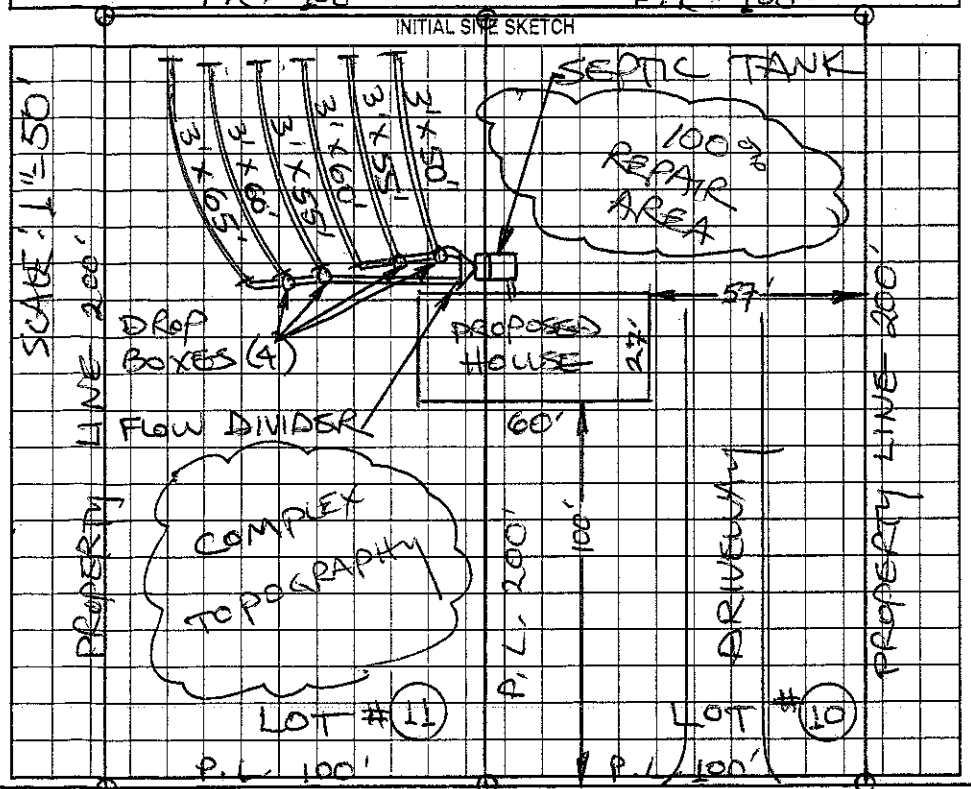

AS BUILT SKETCH

SYSTEM INSTALLED ACCORDING TO INITAL SITE SKETCH

Permit can be suspended or revoked if any false information is supplied toward securing the permit/any unauthorized changes are made to the site/any unauthorized changes are made in the installation of the system. Improvement Permit with plat valid without expiration. Improvement Permit with site plan valid for sixty months. Authorization to Construct is valid for a period equal to that of Improvement Permit – not to exceed sixty months.

X Signed: Jessie M Riggs date 3-20-03 Installed by: PIEDMONT BACKHOE

Improvement Permit by: STEVE HEDRICK date 3-28-03 Operation Permit by: STEVE HEDRICK date 2-16-05

Authorization to Construct by: STEVE HEDRICK date 3-28-03 Existing System Inspection by: _____ date _____

HEALTH DEPT. COPY: WHITE OWNER COPY (FINAL): YELLOW OWNER COPY (INITIAL): PINK