IREDELL COUNTY HEALTH DEPARTMENT

STATESVILLE 704-878-5305 (1) MOORESVILLE 704-664-5281

IMPROVEMENT PERMIT / AUTHORIZATION TO CONSTRUCT / OPERATION PERMIT / EXISTING SYSTEM INSPECTION

(1)

PERMIT# 106855 PIN# 4738-59-3268 DATE 6-24-02

OWNER OR CONTRACTOR HOPE BROTHERS BUILDERS PHONE: Business Home 704-872-4111

ADDRESS 601 BOND ST STATESVILLE NC 28677

LOCATION NC 115 N, TR S, CHIPLEY FORD, TL RIVER RUN ROAD, TR S, YADKIN RIVER ROAD, LOT AT END ON LEFT

SUBDIVISION RIVER RUN BLOCK / SECTION 1 LOT 44 LOT AREA 0.46 ACRE SITE CLASS PS DESIGN FLOW 360 L.T.A.R. 0.30 GPD/FT2

Septic Tank: 1000 Gallons; STB 1012 Date 9-29-02
Pump Tank: 1000 Gallons; PT 17 Date 7-25-03
Pump Make: GOULDS Model VHED5111 Serial No 5045564119
Nitrification Field: No Fields 1 Square Feet EQ.P/200 Linear Feet 300
No Lines FIVE Trench Width 36" Max Trench Bottom Depth 36" ~~Gravel~~ Depth SAND 6" N/A

☑ New System ☐ Repair System Type: I, II, (III), IV, V, VI
System Description: 25% REDUCTION, PUMP
Repair System Description: 50% REDUCTION, LOW-
Maintenance Agreement Required: ☐ Yes ☑ ~~No~~ PRESSURE


☑ House/Mod. Home No. Bedrooms 3
☐ Mobile Home No. Bathrooms 2
☐ Business No. Employees
☐ Other
☐ Slab ☑ Crawl Space ☐ Basement w/plumbing ☐ Basement wo/plumbing

Water Supply: ☐ Individual ☑ ~~Public~~ ☐ Community


Comments/Conditions: (1) INSTALL 25% REDUCTION SYSTEM IN FIVE EQUAL LENGTH LINES AS SHOWN (2) ~~INSTALL~~ SEE ATTACHED SHEETS FOR PUMP & PRESSURE MANIFOLD REQUIREMENTS

Comments/Conditions: V'D LINES & TANKS, PUMP NEEDS V'D ALSO, GOT INFO OFF BOX. NEEDS ELECTRICAL & PRESSURE SYSTEM IS 10' OFF FLAGGED / MARKED P/L. TO FRONT OF FILTER & ~~RISERS~~ RISERS,

INITIAL SITE SKETCH

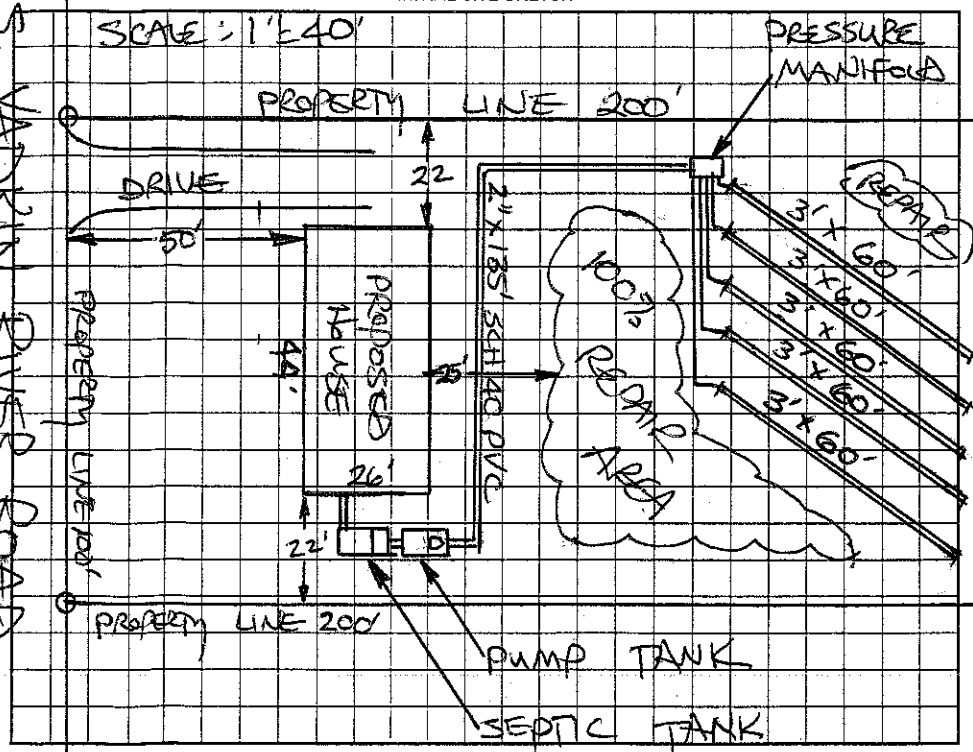

AS BUILT SKETCH

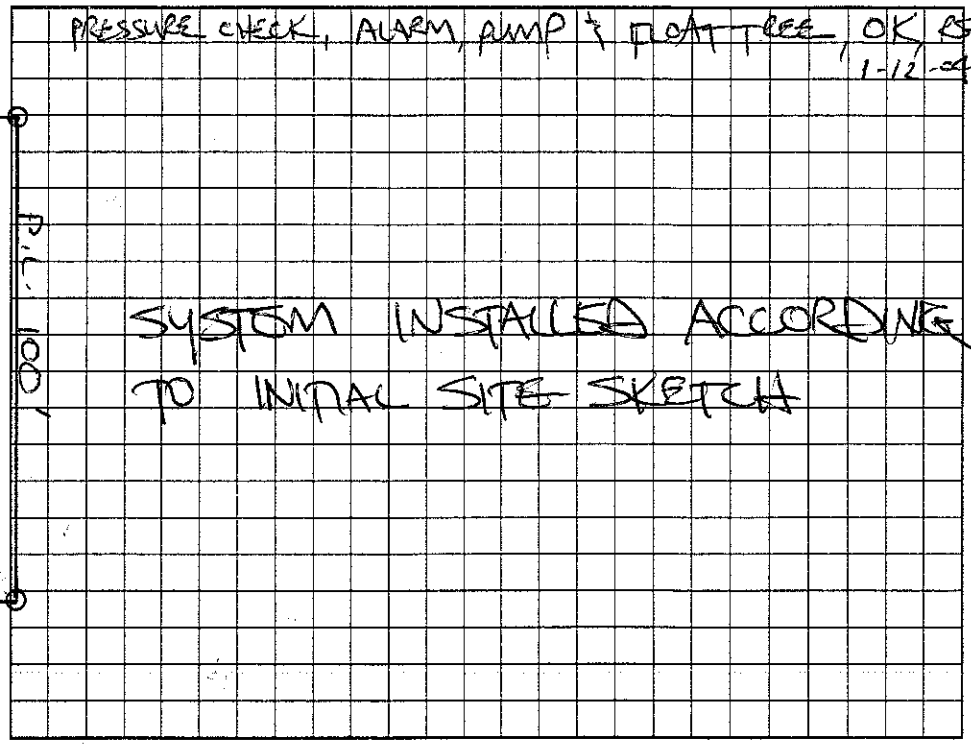

Permit can be suspended or revoked if any false information is supplied toward securing the permit/any unauthorized changes are made to the site/any unauthorized changes are made in the installation of the system. Improvement Permit with plat valid without expiration. Improvement Permit with site plan valid for sixty months. Authorization to Construct is valid for a period equal to that of Improvement Permit – not to exceed sixty months.

Signed: [signature] date

Installed by: ARNIE DUNCAN

Improvement Permit by: STEVE HEDRICK date 6-24-02

Operation Permit by: STEVE HEDRICK date 1-12-04

Authorization to Construct by: STEVE HEDRICK date 6-24-02

Existing System Inspection by: date

HEALTH DEPT. COPY: WHITE OWNER COPY (FINAL): YELLOW OWNER COPY (INITIAL): PINK