IREDELL COUNTY HEALTH DEPARTMENT

Statesville Office (704) 878-5305 Mooresville Office (704) 660-3625 PERMIT # 204616

IMPROVEMENT PERMIT / AUTHORIZATION TO CONSTRUCT / OPERATION PERMIT / EXISTING SYSTEM

PIN # 4738594362

APPLICANT: [illegible] APPLICANT ADDRESS: [illegible] US Hwy 64 West Mocksville

SITE ADDRESS: 147 South Yadkin River Rd. PHONE: [illegible] ALT. PHONE: N/A

SITE DIRECTIONS: [illegible]

SUBDIVISION: River Run II SECTION: 3 LOT # 43 LOT AREA: [illegible] acres DESIGN FLOW: 360 gpd L.T.A.R.: [illegible]

Septic Tank 1000 (gal) STB 760 Date 5-5

Pump Tank (gal) PT Date

Pump Make Model Serial #

Nitrification Fields 1 # Lines 3 Linear Ft: 300

Trench Width 36" Max. Trench Bottom Depth 36" Gravel Depth N/A

☑ New System ☐ Repair ☐ Expansion System Type: I II III IV V VI

System Description: 25% Reduction

Repair System Description: Low Pressure Pipe

Maintenance Agreement Required: ☐ YES ☑ NO

☑ GRAVITY ☐ PRESSURE

☑ Residence No. Bedrooms 3

☐ Business No. Persons 6

☐ Other No. Employees

☐ Slab ☑ Crawl Space

☐ Basement w/plumbing ☐ Basement w/o plumbing

Water Supply


☐ Private

☑ Public


☐ Community

Comments / Conditions: Install a 25% Reduction System to conform with serial distribution. Water line shall be a minimum of 10' from all components of septic system & repair area.

INITIAL SITE SKETCH

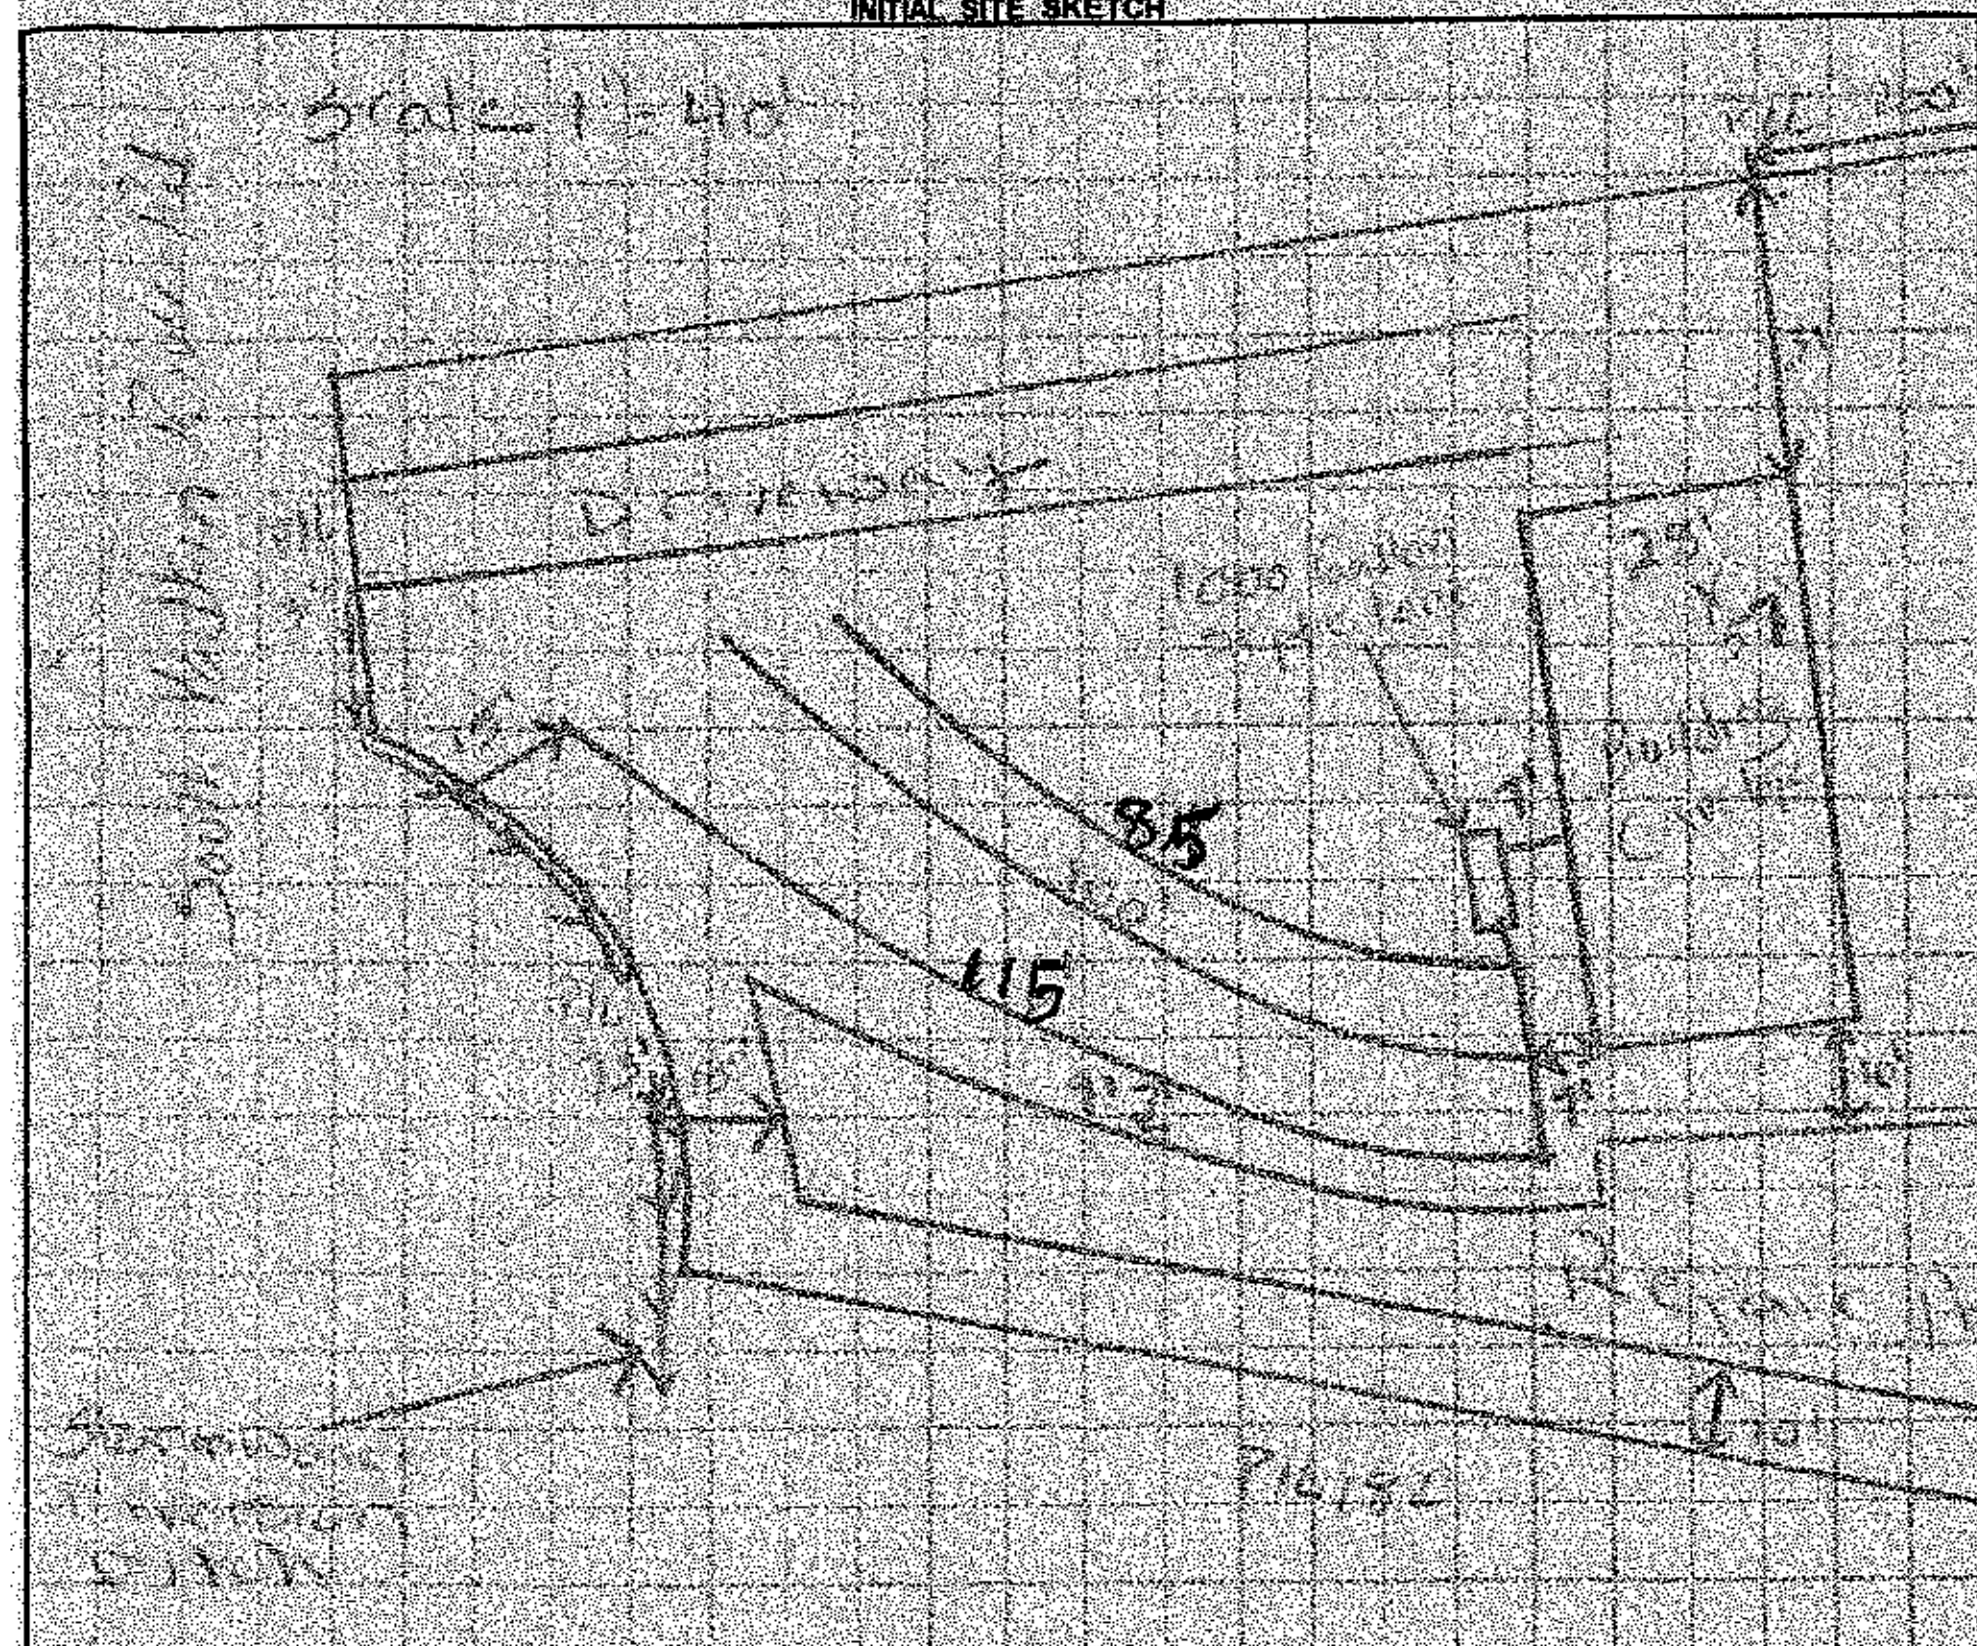

AS BUILT SKETCH

 

Permit can be suspended or revoked if any false information is supplied toward securing the permit / any unauthorized changes are made to the site / any unauthorized changes are made in the installation of the system. **CONTACT A LOCATOR SERVICE PRIOR TO ANY EXCAVATION**

☐ **IMPROVEMENT PERMIT with plat** *valid without expiration.* ☑ **IMPROVEMENT PERMIT with site plan** *valid for 60 mos.* ☑ **AUTHORIZATION TO CONSTRUCT** *valid for period equal to IMPROVEMENT PERMIT--not to exceed 60 mo.*

Owner / Applicant Signature: [signature] Date: [illegible]/14 Installed by: Tim Abee

IMPROVEMENT PERMIT by: [signature] Date: 8-6-14 OPERATION PERMIT by: [signature] Date: 9-30-14

AUTHORIZATION TO CONSTRUCT by: [signature] Date: 8-6-14 Existing System Inspected by: Date: