IREDELL COUNTY HEALTH DEPARTMENT

STATESVILLE 704-878-5305 MOORESVILLE 704-664-5281

IMPROVEMENT PERMIT / AUTHORIZATION TO CONSTRUCT / OPERATION PERMIT / EXISTING SYSTEM INSPECTION

PERMIT# 087289 PIN# 4738 59 5098 DATE 6-5-2000

OWNER OR CONTRACTOR HOPE BROTHERS PHONE: Business 872-9111 Home

ADDRESS 1120 BARKLEY ROAD, STATESVILLE, NC 28677

LOCATION S. CHIPLEY FORD ROAD, TL RIVER RUN ROAD, TR S. YADKIN RIVER RD, LOT AT END ON RIGHT

SUBDIVISION RIVER RUN BLOCK / SECTION II LOT 40 LOT AREA 0.675 ACRE SITE CLASS PS DESIGN FLOW 360 L.T.A.R. C. 30 GPD/FT²

Septic Tank: 1000 Gallons; STB 1012 Date 1-21-01
Pump Tank: ____ Gallons; PT ____ Date ____
Pump Make: ____ Model ~~EQ 70 1260~~ Serial No 300+
Nitrification Field: No Fields 1 Square Feet ~~1260~~ 1200 Linear Feet 400
No Lines Four Trench Width 36" Max Trench Bottom Depth 36" Gravel Depth 12"

☑ New System ☐ Repair System Type: ☐ I ☐ II ☐ 25% Red
System Description: CONVENTIONAL GRAVITY
Repair System Description: CONV. GRAVITY
Maintenance Agreement Required: ☐ Yes ☑ No
☐ Slab ☑ Crawl Space ☐ Basement w/plumbing ☐ Basement wo/plumbing


☑ House/Mod. Home No. Bedrooms 3
☐ Mobile Home No. Bathrooms 2
☐ Business No. Employees ____
☐ Other ____

Water Supply: ☐ Individual ☑ Public ☐ Community


Comments:/Conditions:

Comments /Conditions ① SYSTEM INSTALLED USING 50 "INFILTRATOR" CHAMBERS AS SHOWN BELOW ② SEPTIC TANK WITH RISERS INSTALLED USING "POLYLOK" FILTER

INITIAL SITE SKETCH

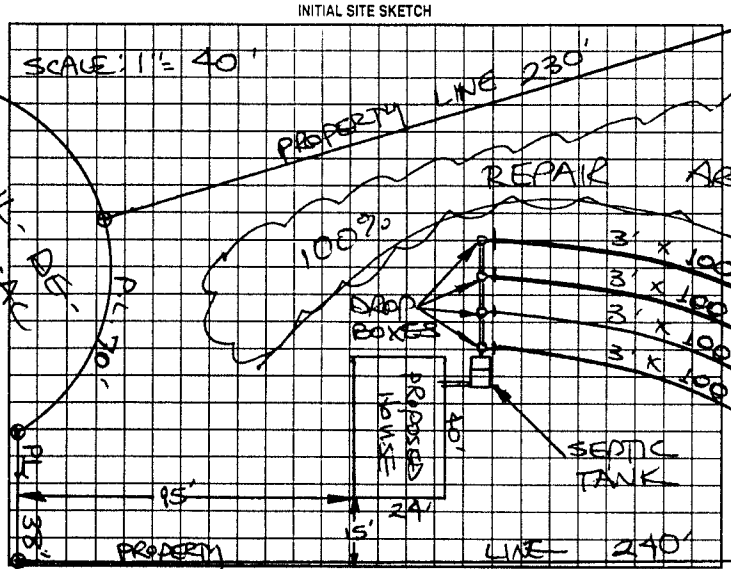

AS BUILT SKETCH

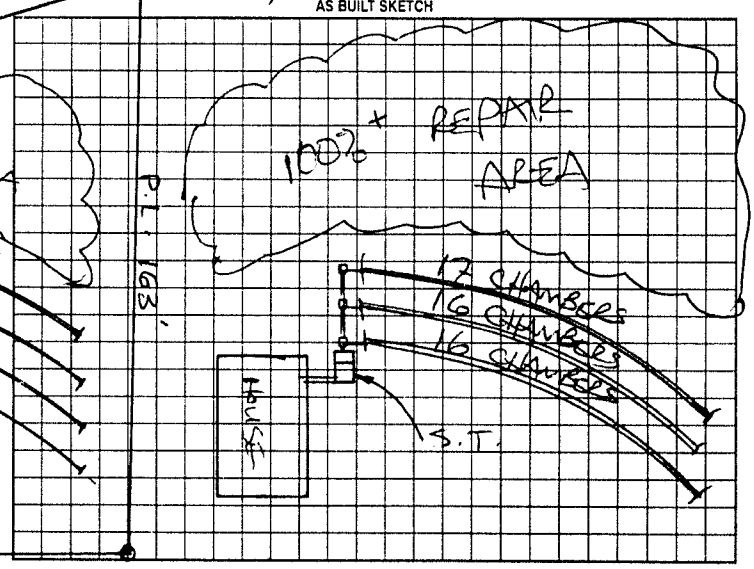

Permit can be suspended or revoked if any false information is supplied toward securing the permit/any unauthorized changes are made to the site/any unauthorized changes are made in the installation of the system. Improvement Permit with plat valid without expiration. Improvement Permit with site plan valid for sixty months. Authorization to Construct is valid for a period equal to that of Improvement Permit – not to exceed sixty months.

Signed: ____ date 6-22-10 Installed by: ARNIE DUNCAN

Improvement Permit by: STEVE HEDRICK date 6-5-2000 Operation Permit by: STEVE HEDRICK date 11-27-01

Authorization to Construct by: STEVE HEDRICK date 6-5-2000 Existing System Inspection by: ____ date ____

HEALTH DEPT. COPY: WHITE OWNER COPY (FINAL): YELLOW OWNER COPY (INITIAL): PINK