IREDELL COUNTY HEALTH DEPARTMENT

STATESVILLE 704-878-5305 ✓ MOORESVILLE 704-664-5281

IMPROVEMENT PERMIT / AUTHORIZATION TO CONSTRUCT / OPERATION PERMIT / EXISTING SYSTEM INSPECTION

PERMIT# 105850 PIN# 4738-61-1914 DATE 5/10/02

OWNER OR CONTRACTOR Michael Woods PHONE Business — Home (704) 872-0179

ADDRESS 131 Martha Lane Statesville N.C. 28625

LOCATION 115 N. (R) S. Chipley Ford Rd, 3rd street 6 miles, (L) on Martha Lane, Lot on Left

SUBDIVISION — BLOCK / SECTION — LOT — LOT AREA 2.03 Ac. SITE CLASS — DESIGN FLOW 480 L.T.A.R. .35 sq ft

Septic Tank: 1,000 Gallons: STB 1012 Date 4/20/93

Pump Tank: — Gallons: PT — Date —

Pump Make: — Model — Serial No —

Nitrification Field: No Fields 1 Square Feet 1371 Linear Feet 457

No Lines 4 Trench Width 36" Max Trench Bottom Depth 36" Gravel Depth 12"

X New System ☐ Repair System Type: I II III IV V VI

System Description: Current Conv. Gravity

Repair System Description: Conv. Gravity

Maintenance Agreement Required: ☐ Yes X No

☐ House/Mod. Home X Mobile Home ☐ Business ☐ Other

No. Bedrooms 4 No. Bathrooms 2 No. Employees —


☐ Slab X Crawl Space ☐ Basement w/plumbing ☐ Basement wo/plumbing

Water Supply: ☐ Individual X Public ☐ Community


Comments/Conditions: ① Replace dist box with drop boxes ② Add two (2) lines below existing lines on contour ③ Keep house min 55' from S.T. + Lines minimum 5' off foundation 406, 70 pb

Comments/Conditions:

INITIAL SITE SKETCH

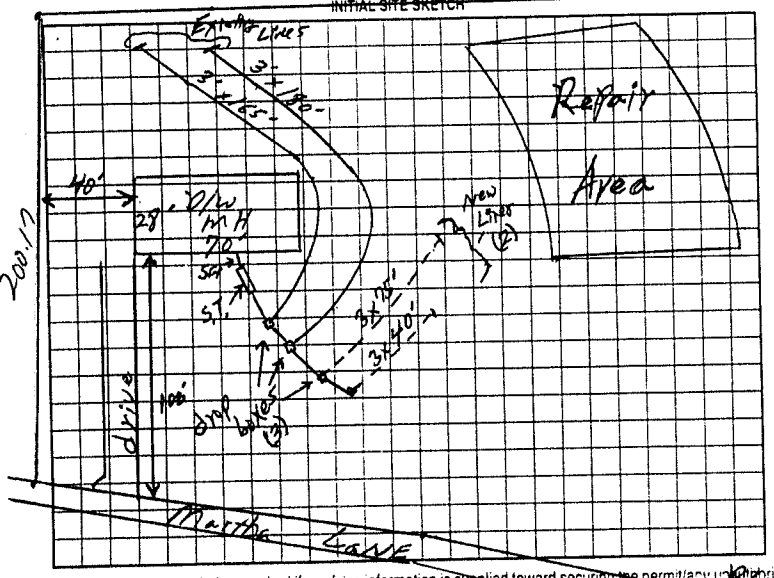

AS BUILT SKETCH

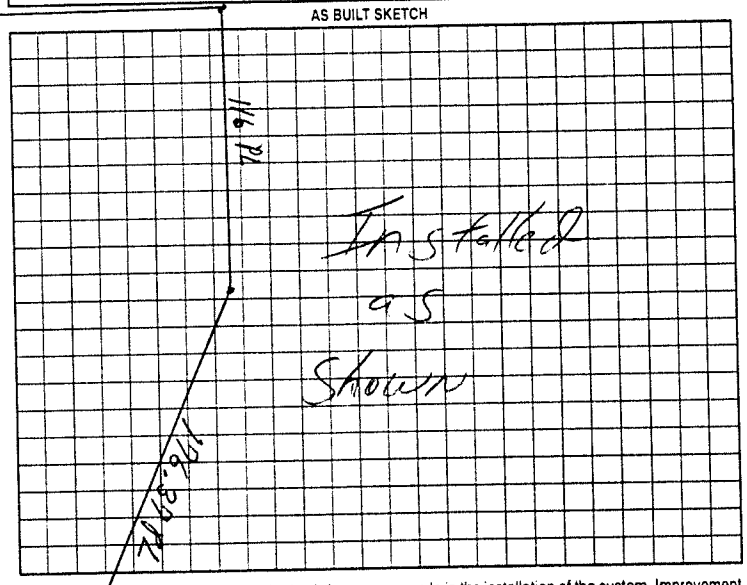

Permit can be suspended or revoked if any false information is supplied toward securing the permit, any unauthorized changes are made to the site, any unauthorized changes are made in the installation of the system. Improvement Permit with plat valid without expiration. Improvement Permit with site plan valid for sixty months. Authorization to Construct is valid for a period equal to that of Improvement Permit – not to exceed sixty months

Signed: Renee Potts date 5-13-02 Installed by: Craig Thompson

Improvement Permit by: William O. Johnson date 5/10/02 Operation Permit by: William O. Johnson date 4/23/02

Authorization to Construct by: William O. Johnson date 5/10/02 Existing System Inspection by: — date —

HEALTH DEPT. COPY: WHITE OWNER COPY (FINAL): YELLOW OWNER COPY (INITIAL): PINK