IREDELL COUNTY HEALTH DEPARTMENT

STATESVILLE 704-878-5305 MOORESVILLE 704-664-5281

IMPROVEMENT PERMIT / AUTHORIZATION TO CONSTRUCT / OPERATION PERMIT / EXISTING SYSTEM INSPECTION

PERMIT# 07936 PIN# 4738 62 6127 DATE 2-19-99

OWNER OR CONTRACTOR BOBBY J. BOYLES, SR PHONE: Business Home 876-3632

ADDRESS 124 MARTHA LANE, STATESVILLE, NC 28625

LOCATION NC 115 N, TR S. CHIPLEY FORD, TL MARTHA LANE, 1ST LOT ON RIGHT

SUBDIVISION BLOCK / SECTION LOT LOT AREA 1.71 ACRES SITE CLASS PS DESIGN FLOW 360 L.T.A.R. 0.30 SQ FT

Septic Tank: 1000 Gallons: STB 794 Date 11-17-98
Pump Tank: Gallons: PT Date
Pump Make: Model Serial No.
Nitrification Field: No. Fields 1 Square Feet 1200 Linear Feet 400
No. Lines FOUR Trench Width 36" Max Trench Bottom Depth 36" Gravel Depth 12"

☑ New System ☐ Repair System Type: I II III IV V VI
System Description: CONVENTIONAL GRAVITY
Repair System Description: CONV. GRAVITY
Maintenance Agreement Required: ☐ Yes ☑ No

☐ House/Mod. Home ☑ Mobile Home ☐ Business ☐ Other
No. Bedrooms 3 No. Bathrooms 2 No. Employees
☐ Slab ☑ Crawl Space ☐ Basement w/plumbing ☐ Basement wo/plumbing


Water Supply: ☐ Individual ☑ Public ☐ Community

Comments/Conditions: REPAIR AREA


SCALE: 1" = 40'

Comments/Conditions: DROP BOXES (4)

INITIAL SITE SKETCH

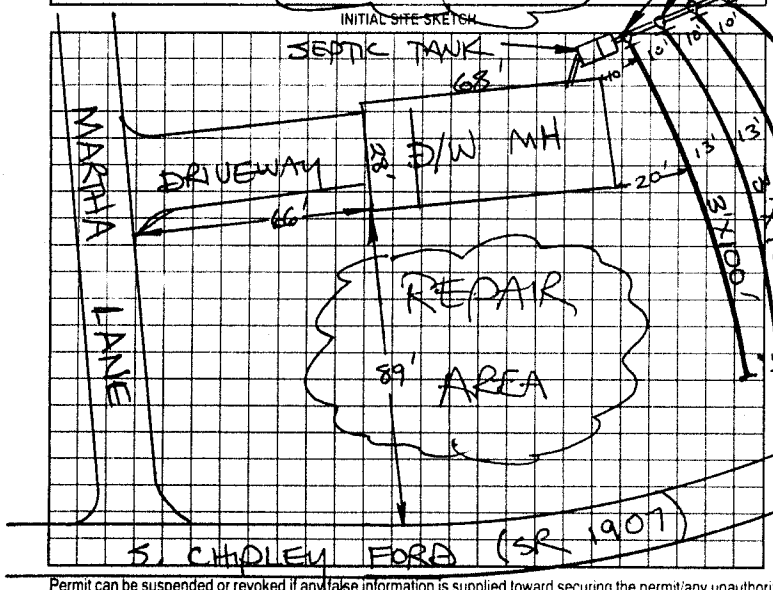

AS BUILT SKETCH

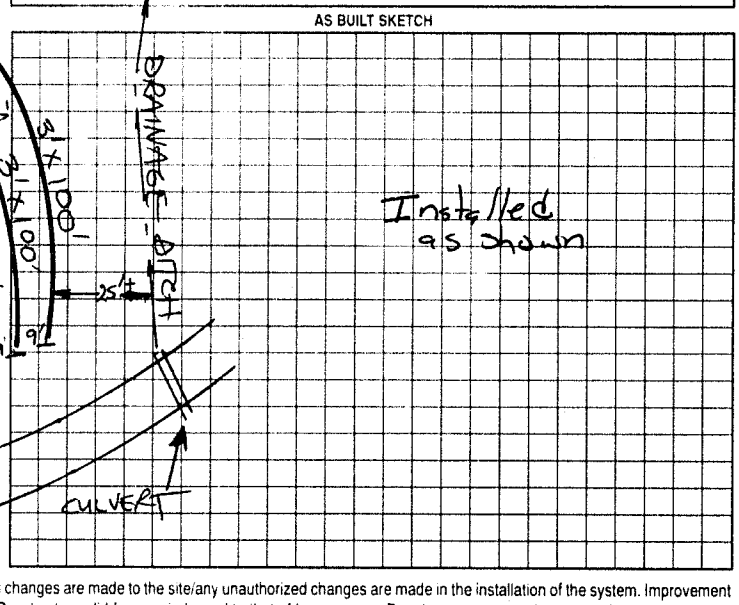

Permit can be suspended or revoked if any false information is supplied toward securing the permit/any unauthorized changes are made to the site/any unauthorized changes are made in the installation of the system. Improvement Permit with plat valid without expiration. Improvement Permit with site plan valid for sixty months. Authorization to Construct is valid for a period equal to that of Improvement Permit - not to exceed sixty months.

Signed: X Bobby Boyles Sr. date 2-19-99 Installed by: Self (Boyles)

Improvement Permit by: STEVE HEDRICK date 2-19-99 Operation Permit by: M-4 COURS date 4-8-99

Authorization to Construct by: STEVE HEDRICK date 2-19-99 Existing System Inspection by: date

HEALTH DEPT. COPY WHITE OWNER COPY (FINAL) YELLOW OWNER COPY (INITIAL) PINK