49108

# IREDELL COUNTY HEALTH DEPARTMENT

STATESVILLE 704-878-5305 MOORESVILLE 704-664-5281

## IMPROVEMENT PERMIT / CERTIFICATE OF COMPLETION / OPERATION PERMIT / EXISTING SYSTEM INSPECTION

PROPERTY DESCRIPTION NO. 17085 DATE 9/27/93 TAX MAP NO. 130-A-18

OWNER OR CONTRACTOR ALAN L. ANDREWS PHONE: Business 872-3600 Home

ADDRESS RT. 1 BOX 411 STVL. NC 28677

LOCATION NC 115 N, TR S. CHIPLEY FORD RD, TL RIVER RUN RD, 2ND DRIVE ON (L)

SUBDIVISION BLOCK / SECTION LOT LOT AREA 8.44 AC SITE CLASS. PS L.T.A.R. 0.35 GPD/FT2

Water Supply: ☒ Individual ☐ Community ☐ Public WELL

Septic Tank: 1000 Gallons; STB 794 Date 5-12-94

Pump Tank: Gallons; PT Date

Nitrification Field: No. Fields 1 Square Feet 1035 Linear Feet 345

No. Lines 3 Trench Width 36 Trench Depth 18-36" Gravel Depth 12"

☒ New System ☐ Repair System Type: I, II, III, IV, V, VI

System Description: CONV. GRAVITY

Repair System Description: CONV. GRAVITY

Maintenance Agreement Required: ☐ Yes ☐ No

☒ House/Mod. Home ☐ Mobile Home ☐ Business ☐ Other PLANNED FOR BASEMENT W/PLBG

No. Bedrooms 3 No. Bathrooms 2 1/2 No. Employees

Garbage Disposal: ☐ Yes ☒ No

Auto. Dishwasher: ☒ Yes ☐ No


Auto. Washing Machine: ☒ Yes ☐ No

Other

☐ Slab ☐ Crawl Space ☐ Basement w/plumbing ☒ Basement wo/plumbing

Comments (1) KEEP SYSTEM MINIMUM 15' FROM BASEMENT, 10' FROM PROPERTY LINE, 100' FROM WELL (2) INSTALL LINES ON CONTOUR, NO DEEPER THAN 36", 9' APART ON CENTER

**INITIAL SITE SKETCH**

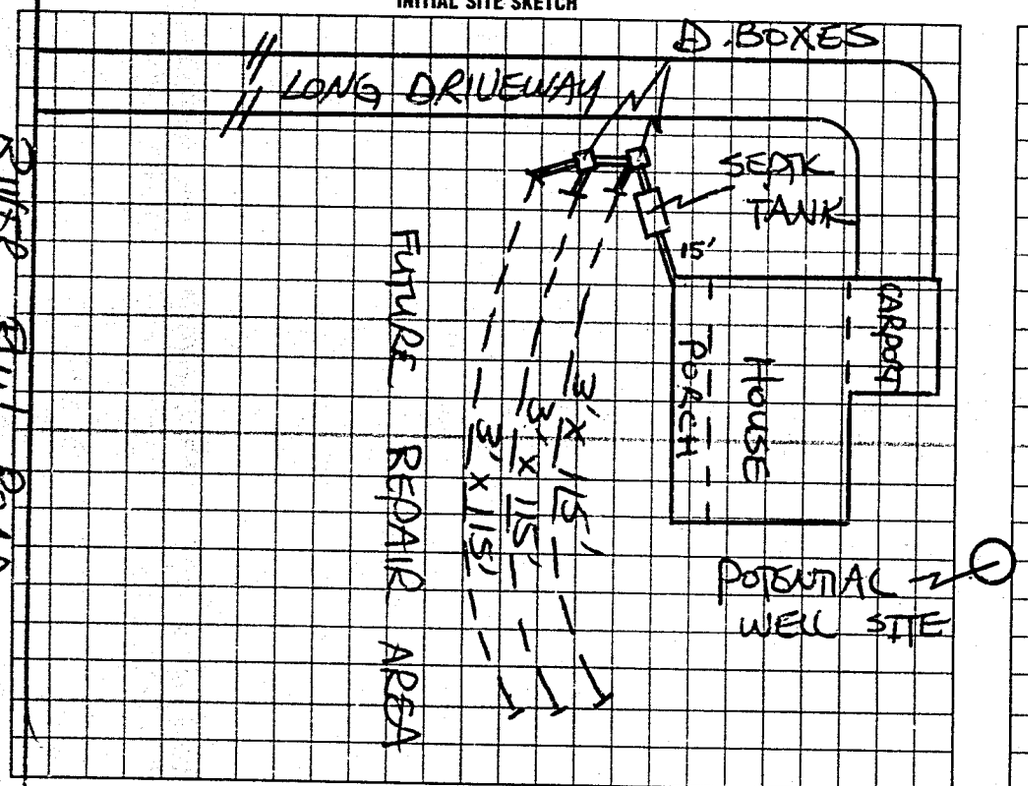


**AS BUILT SKETCH**

SAME AS INITIAL SKETCH

Well located at time of inspection.
less than 100' to septic system
Well located 77' from septic system, (end of lines)
95' from septic tank

I understand that this permit can be suspended or revoked if any false information is supplied toward securing the permit/any unauthorized changes are made to the site/any unauthorized changes are made in the installation of the system. Improvement Permit is valid for 60 months from date of issuance.

Signed: X Alan Andrews

Improvement Permit by: STEVE HEDRICK date 9/27/93

Existing System Inspection by: date

Installed by: A-1 Backhoe

Certificate of Completion by: Michael Q. Dennis date 7-13-94

Operation Permit by: date

HEALTH DEPT. COPY WHITE INSPECTION COPY (FINAL) GREEN OWNER COPY (FINAL) YELLOW INSPECTION COPY (INITIAL) PINK OWNER COPY (INITIAL) GOLD