Julie Ward
Permit # 200795

# IREDELL COUNTY HEALTH DEPARTMENT

STATESVILLE 704-878-5305 — MOORESVILLE 704-664-5261

## IMPROVEMENT PERMIT / CERTIFICATE OF COMPLETION / OPERATION PERMIT / EXISTING SYSTEM INSPECTION

5238

PROPERTY DESCRIPTION NO. 7581 DATE 12/14/93 TAX MAP NO. 136-A-19 Watershed: ☐ Yes ☐ No

OWNER OR CONTRACTOR JOHN E. CHURCH PHONE: Business _____ Home 1264-2197

ADDRESS P.O. BOX 412 MOORESVILLE NC 28115

LOCATION NC 115 N, TR 1 CHIXEN FORD RD R RIVER RUN RD 343 LOT ON (L)

SUBDIVISION _____ BLOCK / SECTION _____ LOT 19 LOT AREA 5.9 ac SITE CLASS PS DESIGN FLOW 360 L.T.A.R. 0.35 gpd/ft

Septic Tank: 1000 Gallons: STB 799 Date 2/2/95 — New System ☐ Repair System Type: ☒ III W. C. ☐ I

Pump Tank: _____ Gallons: PT _____ Date _____ — System Description: CONV. GRAVITY

Pump Make: _____ Model _____ Serial No. _____ — Repair System Description: CONV. GRAVITY

Application Rate: No. Lines 1 Square Feet 1035 Linear Feet 345 — Maintenance Agreement Required: ☐ Yes ☐ No

No. Lines 3 Trench Width 36" Min. Trench Bottom Depth 18"-36" Gravel Depth 12" ☐ Mat ☐ Crawl Space ☒ Basement w/plumbing ☐ Basement w/o plumbing


Dwelling/Mod. Home ☐ Mobile Home ☐ Business ☐ Other — No. Bedrooms 3 — Ab. Bathrooms 2.5 — Ab. Employees _____

Water Supply: ☒ Individual ☐ Community ☐ Public ☐ WFL


Comments: (1) KEEP SYSTEM MINIMUM 5' FROM HOUSE, 10' FROM PROPERTY LINE, 100' FROM WELL (2) INSTALL LINES ON CONTOUR, NO DEEPER THAN 36", 9' APART ON CENTER

Comments:

INITIAL SITE SKETCH

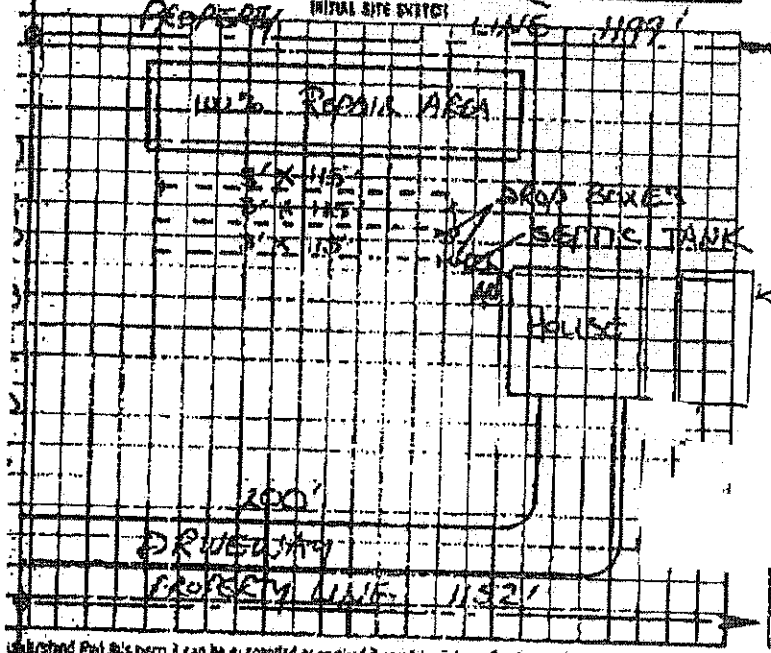


AS BUILT SKETCH

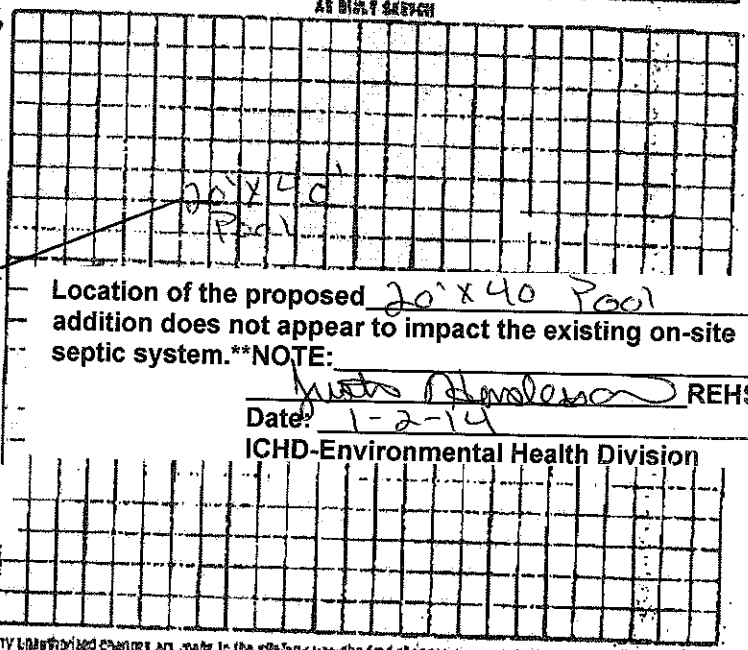


Location of the proposed 20'x40 Pool addition does not appear to impact the existing on-site septic system.**NOTE:

Justin Henderson REHS

Date: 1-2-14

ICHD-Environmental Health Division

I understand that this permit can be suspended or revoked if any false information is supplied toward securing the permit/any unauthorized changes are made to the originally installed system. Improvement Permit is valid for 60 months from date of issuance. Any additional charges are made in the installation of this system.

Signed: X Amanda Owen

Improvement Permit by: STEVE HEDRICK date 12/14/93

Septic System Inspector by: _____ date _____

Initial by: JAMES HUDLER

Certificate of Completion by: STEVE HEDRICK date 4/28/95

Operation Permit by: _____ date _____

IREDELL ENHLTH STVL PAGE 02

05/17/2000 07:47 7048713483

FEB. 21 1995 5:29 PG.11 OF 11