IREDELL COUNTY HEALTH DEPARTMENT

STATESVILLE 704-878-5305 MOORESVILLE 704-664-5281

IMPROVEMENT PERMIT / AUTHORIZATION TO CONSTRUCT / OPERATION PERMIT / EXISTING SYSTEM INSPECTION

PERMIT# 079581 PIN# 4738683690 DATE 3-5-99

OWNER OR CONTRACTOR Donald Hefner PHONE: Business _____ Home 876-2898

ADDRESS 3667 S Chipley Ford Statesville

LOCATION 115N TR S Chipley Ford on R past River Run

SUBDIVISION _____ BLOCK / SECTION _____ LOT _____ LOT AREA 0.73Ac SITE CLASS. _____ DESIGN FLOW _____ L.T.A.R. _____

Septic Tank: Existing Gallons; STB _____ Date _____
Pump Tank: _____ Gallons; PT _____ Date _____
Pump Make: _____ Model _____ Serial No. _____
Nitrification Field: No Fields ____ Square Feet _____ Linear Feet _____
No Lines _____ Trench Width _____ Max Trench Bottom Depth _____ Gravel Depth _____

☐ New System ☐ Repair System Type: I. II. III. IV. V. VI
System Description: _____
Repair System Description: _____
Maintenance Agreement Required: ☐ Yes ☐ No


☒ House/Mod. Home No. Bedrooms 3
☒ Mobile Home No. Bathrooms 2
☐ Business No. Employees ____
☐ Other _____
☐ Slab ☒ Crawl Space ☐ Basement w/plumbing ☐ Basement wo/plumbing

Water Supply: ☒ Individual ☐ Public ☐ Community


Comments/Conditions:

Comments/Conditions
Existing System check
Recommend clearing tank

INITIAL SITE SKETCH

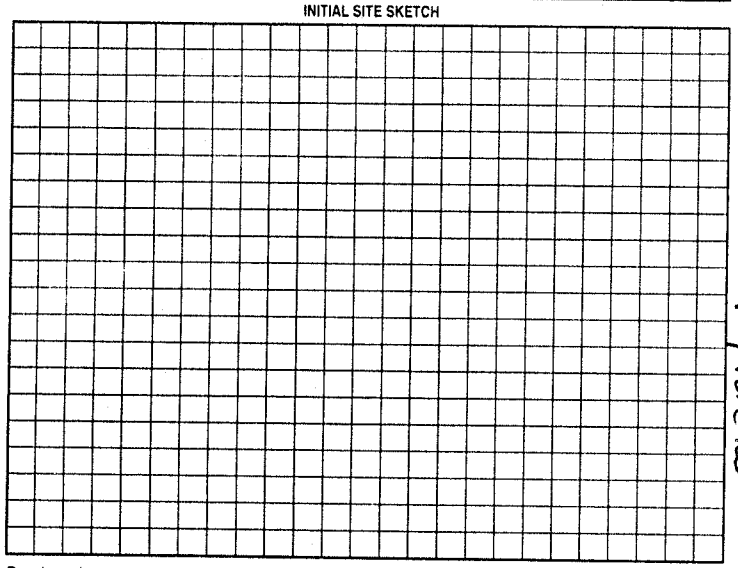

AS BUILT SKETCH

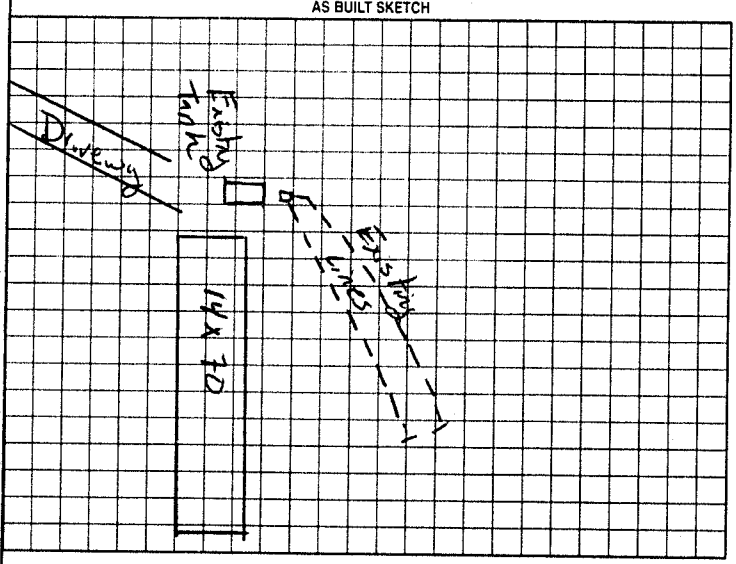

Permit can be suspended or revoked if any false information is supplied toward securing the permit/any unauthorized changes are made to the site/any unauthorized changes are made in the installation of the system. Improvement Permit with plat valid without expiration. Improvement Permit with site plan valid for sixty months. Authorization to Construct is valid for a period equal to that of Improvement Permit – not to exceed sixty months.

Signed: _____ date _____

Improvement Permit by: _____ date _____

Authorization to Construct by: _____ date _____

Installed by: _____

Operation Permit by: _____ date _____

Existing System Inspection by: Mark C. Cutshall date 3-5-99

HEALTH DEPT. COPY: WHITE OWNER COPY (FINAL): YELLOW OWNER COPY (INITIAL): PINK