IREDELL COUNTY HEALTH DEPARTMENT

STATESVILLE 704-878-5305 MOORESVILLE 704-664-5281 (C1)

IMPROVEMENT PERMIT / AUTHORIZATION TO CONSTRUCT / OPERATION PERMIT / EXISTING SYSTEM INSPECTION

PERMIT# 128862 PIN# 4738-70-4307 DATE 6.3.05

OWNER OR CONTRACTOR TMR DEVELOPER, INC PHONE: Business 704-433-2582 Home 704-639-9959

ADDRESS 703 WILDWOOD DRIVE, SALISBURY NC 28146

LOCATION NC 115 N, TR S. CHIPLEY FORD RD, TR BLUEGILL LANE, 0.3 MILE ON RIGHT

SUBDIVISION _____ BLOCK / SECTION _____ LOT _____ LOT AREA 3.694 ACRES SITE CLASS. PS DESIGN FLOW 360 L.T.A.R. 0.32 GPD (EXISTING)

Septic Tank: 1000 Gallons; STB _____ Date _____
Pump Tank: _____ Gallons; PT _____ Date _____
Pump Make: _____ Model _____ Serial No. _____
Nitrification Field: No Fields 1 Square Feet 1125 Linear Feet 375
No Lines THREE Trench Width 36" Max Trench Bottom Depth 36" Gravel Depth 12"

☐ New System ☐ Repair System Type: I, II, III, IV, V, VI
System Description: CONVENTIONAL, GRAVITY
Repair System Description: _____
Maintenance Agreement Required: ☐ Yes ☒ No

☒ House/Mod. Home No. Bedrooms 3
☐ Mobile Home No. Bathrooms 2
☐ Business No. Employees _____
☐ Other _____

☐ Slab ☒ Crawl Space ☐ Basement w/plumbing ☐ Basement w/o plumbing


Water Supply:
☐ Individual
☐ Public
☐ Community
WELL

Comments:/Conditions:

Comments:/Conditions:

INITIAL SITE SKETCH

AS BUILT SKETCH

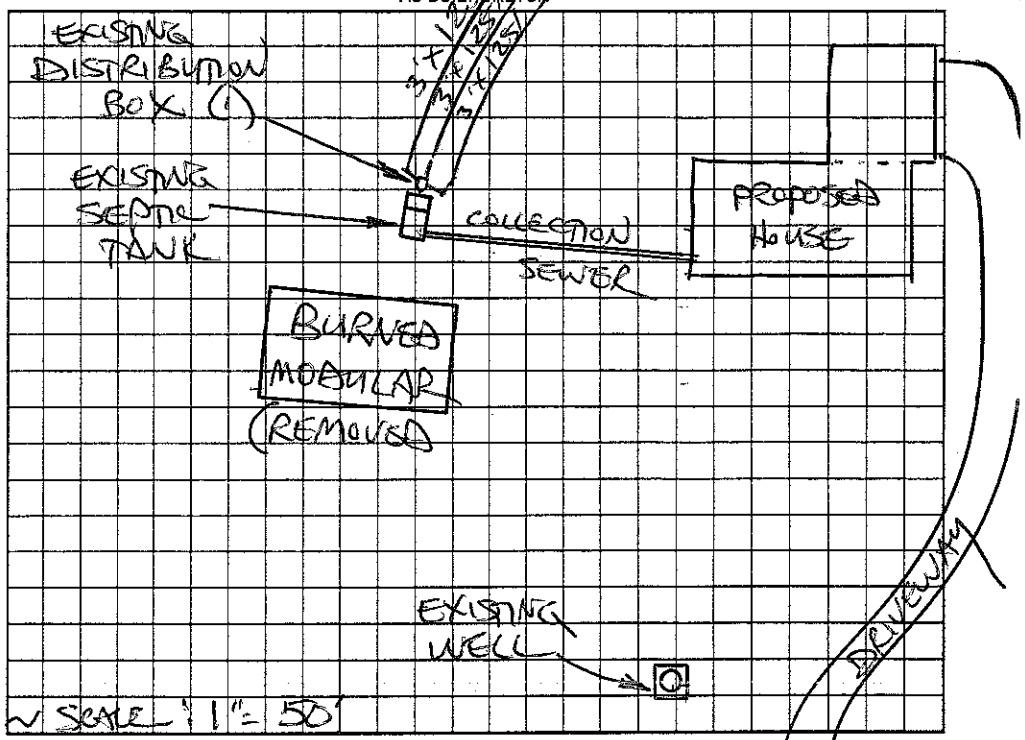

Permit can be suspended or revoked if any false information is supplied toward securing the permit/any unauthorized changes are made to the site/any unauthorized changes are made in the installation of the system. Improvement Permit with plat valid without expiration. Improvement Permit with site plan valid for sixty months. Authorization to Construct is valid for a period equal to that of Improvement Permit – not to exceed sixty months.

Signed: _____ date _____

Improvement Permit by: _____ date _____

Authorization to Construct by: _____ date _____

Installed by: BLUEGILL LANE (SR 1954

Operation ~~Permit by~~: _____ date _____

Existing System Inspection by: STEVE HEDRICK date 6-3-05

HEALTH DEPT. COPY: WHITE OWNER COPY (FINAL): YELLOW OWNER COPY (INITIAL): PINK