IREDELL COUNTY HEALTH DEPARTMENT

STATESVILLE 704-878-5305 MOORESVILLE 704-664-5281

48606

IMPROVEMENT PERMIT / CERTIFICATE OF COMPLETION / OPERATION PERMIT / EXISTING SYSTEM INSPECTION

PROPERTY DESCRIPTION NO. 16849 DATE 8-26-93

OWNER OR CONTRACTOR Lynn Johnson PHONE: Business _____ TAX MAP NO. 106 A 4C

ADDRESS Rt 11 Box 160 Statesville Home 876-2919

LOCATION Chipley Ford Rd North TR BlueGill Rd 1/4 mi on left Back out in Field

SUBDIVISION _____ BLOCK / SECTION _____ LOT _____ LOT AREA 80 acres SITE CLASS. PS. L.T.A.R. .35

Water Supply: ☑ Individual ☐ Community ☐ Public

Septic Tank: 1000 Gallons; STB 786 Date 8-11-93

Pump Tank: _____ Gallons; PT _____ Date _____

Nitrification Field: No Fields 1 Square Feet 1035 Linear Feet 345

No Lines 3 Trench Width 36 Trench Depth 18"+36" Gravel Depth 12

☑ New System ☐ Repair System Type: I. II. IV. V. VI

System Description: Conv. Gravity

Repair System Description: " "

Maintenance Agreement Required: ☐ Yes ☑ No

☑ House/Mod. Home No. Bedrooms 3

☐ Mobile Home No. Bathrooms 2

☐ Business No. Employees _____

☐ Other _____

Garbage Disposal: ☐ Yes ☑ No

Auto. Dishwasher: ☐ Yes ☐ No


Auto. Washing Machine: ☐ Yes ☐ No

Other _____


☐ Slab ☑ Crawl Space ☐ Basement w/plumbing ☐ Basement wo/plumbing

Comments well Not located at time of this inspection

INITIAL SITE SKETCH

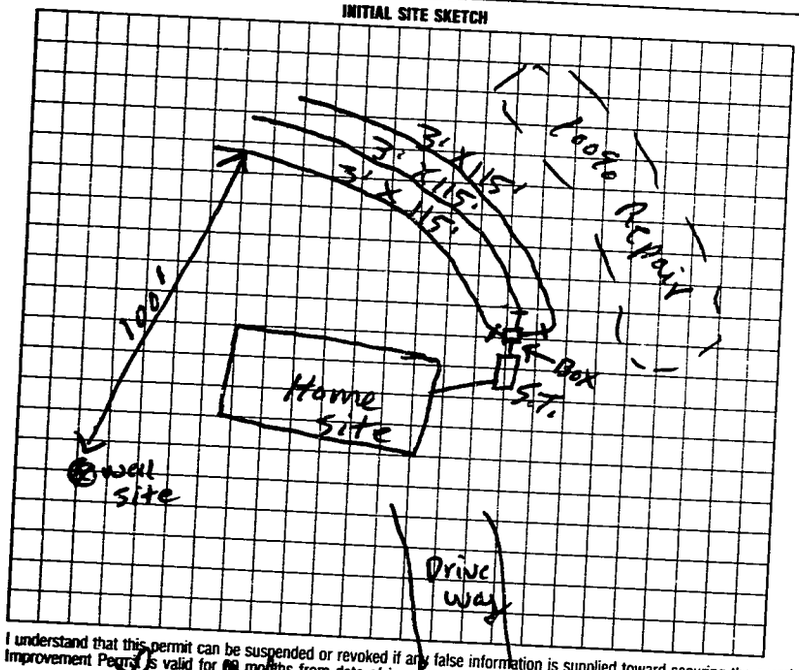

AS BUILT SKETCH

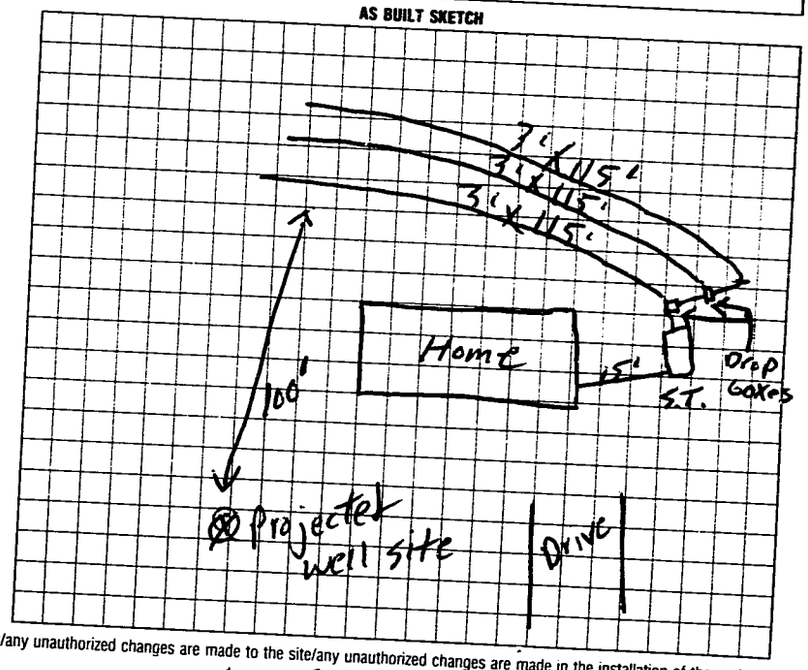

I understand that this permit can be suspended or revoked if any false information is supplied toward securing the permit/any unauthorized changes are made to the site/any unauthorized changes are made in the installation of the system. Improvement Permit is valid for 60 months from date of issuance.

Signed: Lynn Johnson

Improvement Permit by: L. C. Moore date 8-26-93

Existing System Inspection by: _____ date _____

Installed by: West Lincoln S.T. Co.

Certificate of Completion by: L. C. Moore date 10-6-93

Operation Permit by: _____ date _____

HEALTH DEPT. COPY: WHITE INSPECTION COPY (FINAL): GREEN OWNER COPY (FINAL): YELLOW INSPECTION COPY (INITIAL): PINK OWNER COPY (INITIAL): GOLD