IREDELL COUNTY HEALTH DEPARTMENT

STATESVILLE 704-878-5305 MOORESVILLE 704-664-5281

48606

IMPROVEMENT PERMIT / CERTIFICATE OF COMPLETION / OPERATION PERMIT / EXISTING SYSTEM INSPECTION

PROPERTY DESCRIPTION NO. 16849 DATE 8-26-93 TAX MAP NO. 106 A 4C

OWNER OR CONTRACTOR Lynn Johnson PHONE: Business Home 876-2919

ADDRESS Rt #1 Box 1169 Statesville

LOCATION Shipley Ford Rd North TR BlueGill Rd 1/4 mi on left Backout in Field

SUBDIVISION BLOCK / SECTION LOT LOT AREA 8.0 acres SITE CLASS. PS. L.T.A.R. .35

Water Supply: ☑ Individual ☐ Community ☐ Public

Septic Tank: 1000 Gallons: STB 786 Date 8-11-93

Pump Tank: Gallons: PT Date

Nitrification Field: No Fields 1 Square Feet 1035 Linear Feet 345

No Lines 3 Trench Width 36 Trench Depth 15to36 Gravel Depth 12

☑ New System ☐ Repair System Type: I. II. IV. V. VI

System Description: Conv. Gravity

Repair System Description: " "

Maintenance Agreement Required: ☐ Yes ☑ No

☑ House/Mod. Home No. Bedrooms 3

☐ Mobile Home No. Bathrooms 2

☐ Business No. Employees

☐ Other

☐ Slab ☑ Crawl Space ☐ Basement w/plumbing ☐ Basement wo/plumbing

Garbage Disposal: ☐ Yes ☑ No


Auto. Dishwasher: ☐ Yes ☐ No

Auto. Washing Machine: ☑ Yes ☐ No


Other

Comments well Not located at time of this inspection

INITIAL SITE SKETCH

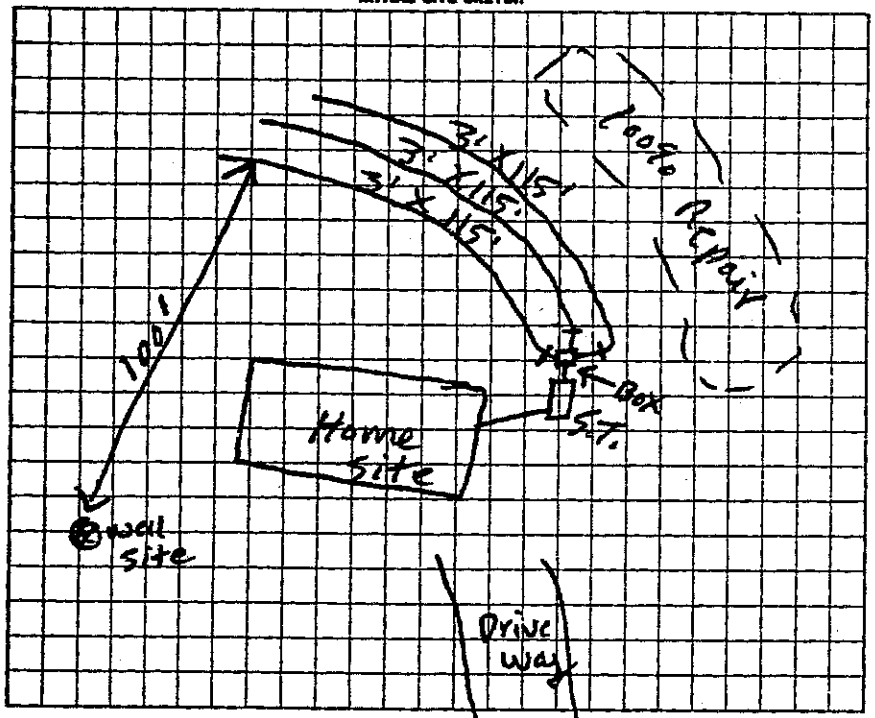

AS BUILT SKETCH

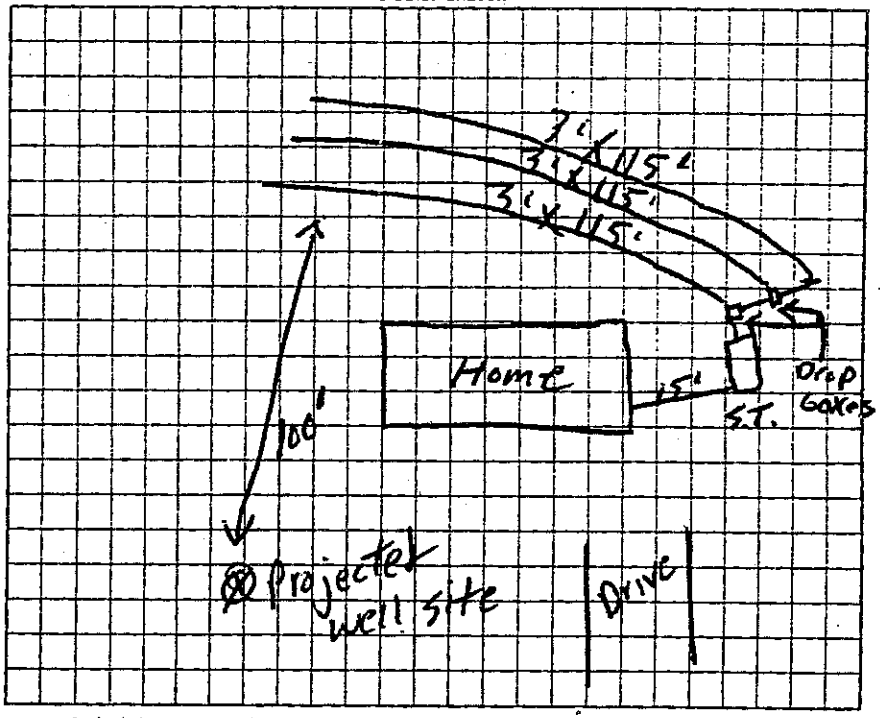

I understand that this permit can be suspended or revoked if any false information is supplied toward securing the permit/any unauthorized changes are made to the site/any unauthorized changes are made in the installation of the system. Improvement Permit is valid for 60 months from date of issuance.

Signed: x Lynn Johnson

Improvement Permit by: E. C. Moore date 8-26-93

Existing System Inspection by: date

Installed by: West Lincoln S.T. Co.

Certificate of Completion by: E. C. Moore date 10-6-93

Operation Permit by: date

HEALTH DEPT COPY (INITIAL): YELLOW INSPECTION COPY (INITIAL): PINK OWNER COPY (INITIAL): GOLD

The location of the proposed GARAGE (22' X 26') addition does not appear to impact the existing septic system.

**NOTE: KEEP GARAGE MINIMUM 5' FROM SYSTEM

R. STRUE HEDRICK REHS

Date: 10-18-2010

ICHD-Environmental Health Division