IREDELL COUNTY HEALTH DEPARTMENT

STATESVILLE 704-878-5305 MOORESVILLE 704-664-5281

IMPROVEMENT PERMIT / AUTHORIZATION TO CONSTRUCT / OPERATION PERMIT / EXISTING SYSTEM INSPECTION

PERMIT# 124939 PIN# 4738-81-3435 DATE 12-13-04

OWNER OR CONTRACTOR KARIN BEDINGER PHONE: Business 704-929-0450 Home 704-876-2377

ADDRESS 160 VICTORY FARM LANE STATESVILLE NC 28625

LOCATION S. CHIPLEY FORD ROAD, TR BLUEGILL LANE, 0.25 TL (AT CURVE), 2ND DRIVE TO RIGHT, ON LEFT 480'

SUBDIVISION _____ BLOCK / SECTION _____ LOT _____ LOT AREA 7.23 ACRES SITE CLASS. PS DESIGN FLOW 360 L.T.A.R. 0.25 GAD/FT²

Septic Tank: 1000 Gallons; STB 825 Date 3.4.05
Pump Tank: _____ Gallons; PT _____ Date _____
Pump Make: _____ Model _____ Serial No. _____
Nitrification Field: No. Fields 1 Square Feet 1440 Linear Feet 480
No. Lines SIX Trench Width 36" Max Trench Bottom Depth 36" Gravel Depth 12"

☑ New System ☐ Repair System Type: I, (II), III, IV, V, VI
System Description: CONVENTIONAL GRAVITY
Repair System Description: CONVENTIONAL GRAVITY
Maintenance Agreement Required: ☐ Yes ☑ No
☐ Slab ☑ Crawl Space ☐ Basement w/plumbing ☐ Basement wo/plumbing


☑ House/Mod. Home No. Bedrooms 3
☐ Mobile Home No. Bathrooms _____
☐ Business No. Employees _____
☐ Other _____

Water Supply: ☑ Individual ☐ Public ☐ Community
WELL


Comments/Conditions: ① INSTALL DRAINLINES ON CONTOUR AS FLAGGED
② NO VEHICULAR TRAFFIC ALLOWED OVER DRAINFIELD

Comments/Conditions: SEPTIC TANK WITH MARKER INSTALLED USING "PolyLok" FILTER

INITIAL SITE SKETCH

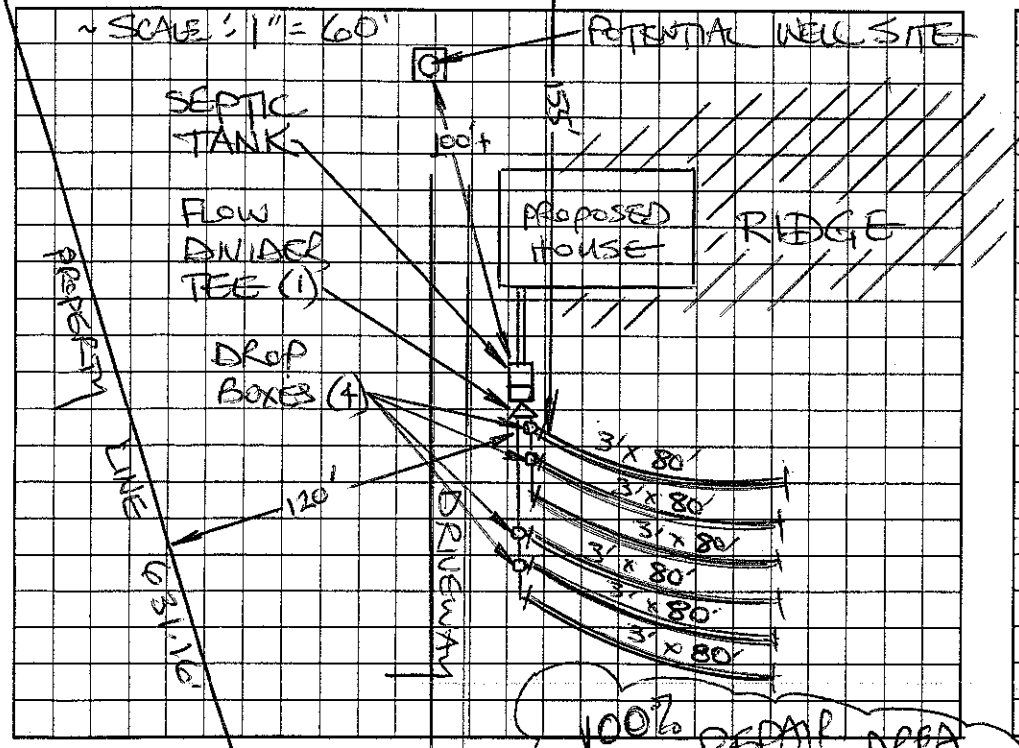

AS BUILT SKETCH

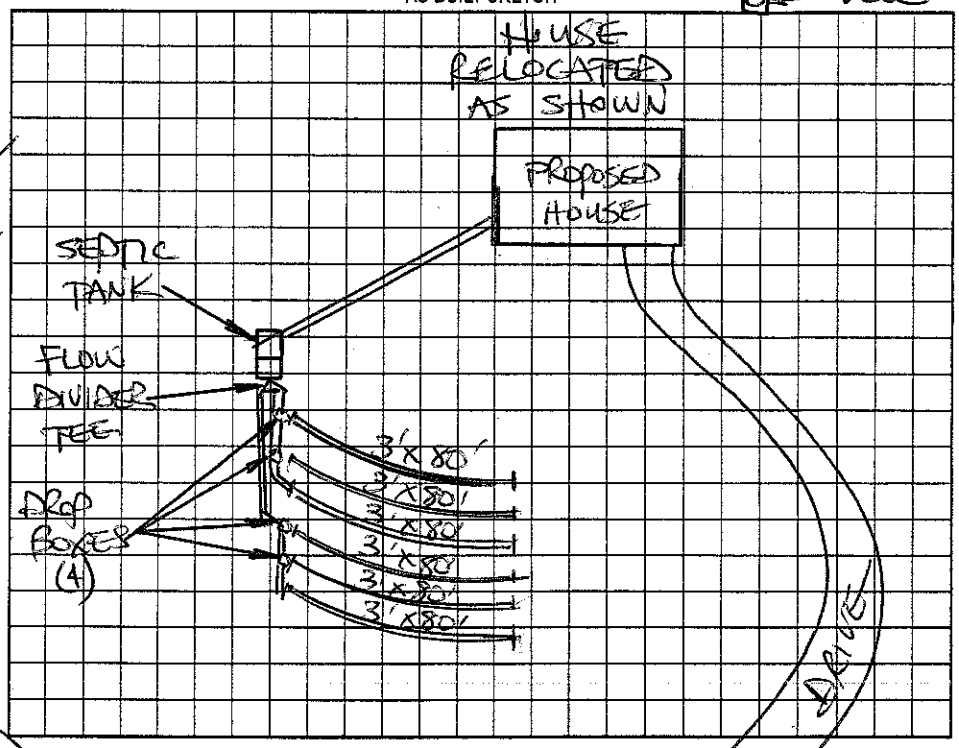

Permit can be suspended or revoked if any false information is supplied toward securing the permit/any unauthorized changes are made to the site/any unauthorized changes are made in the installation of the system. Improvement Permit with plat valid without expiration. Improvement Permit with site plan valid for sixty months. Authorization to Construct is valid for a period equal to that of Improvement Permit – not to exceed sixty months.

Signed: Karin R. Bedinger date 12-14-04
Improvement Permit by: STEVE HEDRICK date 12-13-04
Authorization to Construct by: STEVE HEDRICK date 2-1-05

Installed by: ANDY DANIELS
Operation Permit by: STEVE HEDRICK date 5-3-05
Existing System Inspection by: _____ date _____

HEALTH DEPT. COPY: WHITE OWNER COPY (FINAL): YELLOW OWNER COPY (INITIAL): PINK