IREDELL COUNTY HEALTH DEPARTMENT

STATESVILLE 704-878-5305 @ MOORESVILLE 704-664-5281

IMPROVEMENT PERMIT / AUTHORIZATION TO CONSTRUCT / OPERATION PERMIT / EXISTING SYSTEM INSPECTION

PERMIT # 154058 PIN # 4739028649 DATE 12-30-08

OWNER or APPLICANT Nathan & Summer Comer PHONE: Business Home: 704-876-3571

OWNER or APPLICANT ADDRESS 113 Ichue Rd

LOCATION / DIRECTIONS Hwy 115N; (R) on Snow Creek, site on L before N. Chipley Ford

SUBDIVISION n/a BLOCK / SECTION n/a LOT # n/a LOT AREA n/a DESIGN FLOW 360 L.T.A.R. .3

Septic Tank 1000 Gallons: STB 1012 Date 2-19-10

Pump Tank ____ Gallons: P.T. ____ Date ____

Pump Make ____ Model ____ Serial # ____

Nitrification Field No Fields 1 No Lines 3 Linear Feet 300

Trench Width 36" Max. Trench Bottom Depth 36" Gravel Depth n/a

[X] New System [ ] Repair [ ] Expansion System Type I (II) III IV V VI

System Description: 25% Reduction Gravity

Repair System Description: 25% Reduction Gravity

Maintenance Agreement Required [ ] YES [X] NO

[X] GRAVITY [ ] PRESSURE

[X] Residence No. Bedrooms 3

[ ] Business No. Persons ____

[ ] Other No. Employees ____

[ ] Slab [ ] Crawl Space


[X] Basement w/plumbing [ ] Basement w/o plumbing

Water Supply: [ ] Private [X] Public [ ] Community


Comments / Conditions

Comments / Conditions

INITIAL SITE SKETCH

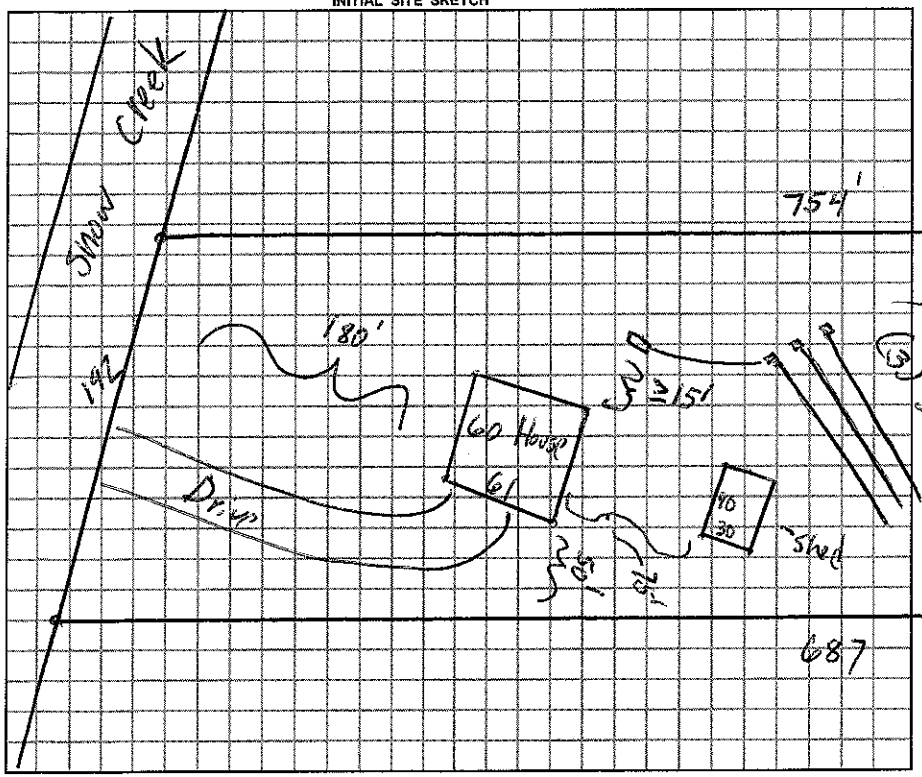

AS BUILT SKETCH

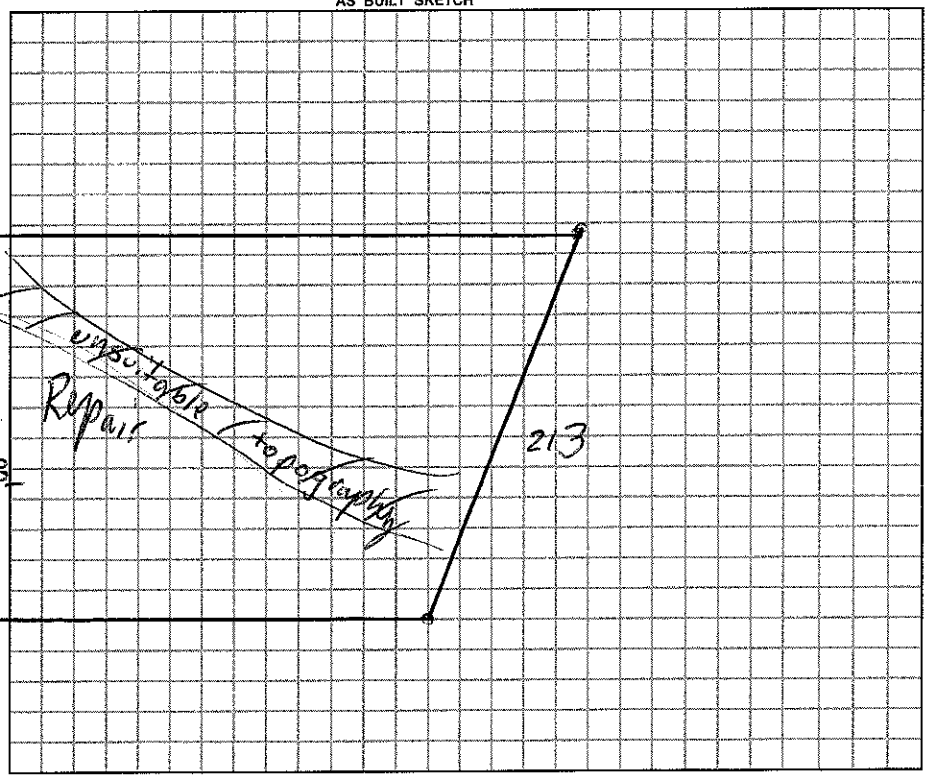

Permit can be suspended or revoked if any false information is supplied toward securing the permit / any unauthorized changes are made to the site / any unauthorized changes are made in the installation of the system.

[ ] *IMPROVEMENT PERMIT w / plat valid without expiration.* [X] *IMPROVEMENT PERMIT w / site plan valid for 60 mos.* [X] *AUTHORIZATION TO CONSTRUCT valid for period equal to IMPROVEMENT PERMIT-not to exceed 60 mo.*

Owner / Applicant Signature: Nathan Comer Date 12-30-08

Improvement Permit by: James Date 12-30-08

Authorzation to Construct by: James Date 12-30-08

Installed by: Piedmont Grading

Operation Permit by: James Date: 1-30-10

Existing System Inspected by: ____ Date: ____

YOU SHOULD CONTACT A LOCATOR SERVICE PRIOR TO ANY EXCAVATION.

WHITE COPY Environmental Health YELLOW COPY (Final) Owner / Applicant PINK COPY (Initial) Owner / Applicant