IREDELL COUNTY HEALTH DEPARTMENT

STATESVILLE 704-878-5305 MOORESVILLE 704-664-5281

IMPROVEMENT PERMIT / CERTIFICATE OF COMPLETION / OPERATION PERMIT / EXISTING SYSTEM INSPECTION

PROPERTY DESCRIPTION NO. 19200 DATE 7/18/94 TAX MAP NO. 146-A-7 (PART)

OWNER OR CONTRACTOR TIM BRADDOCK PHONE: Business 871-9833 Home Watershed: ☐ Yes ☑ No

ADDRESS 109 BESS RD STVL NC 28677

LOCATION NC 115 N, TR HAM'S GROVE CH. RD, TR N. CHIPLEY FORD, ~0.4 MILES ON (L), BACK OFF RD

SUBDIVISION BLOCK / SECTION LOT LOT AREA 3.489 AC SITE CLASS PS DESIGN FLOW 360 L.T.A.R. 0.33 GPD/FT²

Septic Tank: 1000 Gallons; STB 1012 Date 4/10/94

Pump Tank: Gallons; PT Date

Pump Make: Model Serial No.

Nitrification Field: No. Lines 1 Square Feet 1080 Linear Feet 360

No Lines 3 Trench Width 36" Max Trench Bottom Depth 18-36" Gravel Depth 12"

☑ New System ☐ Repair System Type: I (II) III, IV, V, VI

System Description: CONV, GRAVITY

Repair System Description: CONV, GRAVITY

Maintenance Agreement Required: ☐ Yes ☑ No

☐ Slab ☑ Crawl Space ☐ Basement w/plumbing ☐ Basement wo/plumbing

☐ House/Mod. Home ☑ Mobile Home ☐ Business ☐ Other


No. Bedrooms 3 No. Bathrooms 2 No. Employees

Water Supply: ☑ Individual ☐ Community ☐ Public WELL

Comments: (1) KEEP SYSTEM MINIMUM 5' FROM MH, 10' FROM PROPERTY LINE, 100' FROM WELL (2) INSTALL LINES AS SHOWN ON CONTOUR NO DEEPER THAN 36", 9' APART ON CENTER

Comments:

INITIAL SITE SKETCH

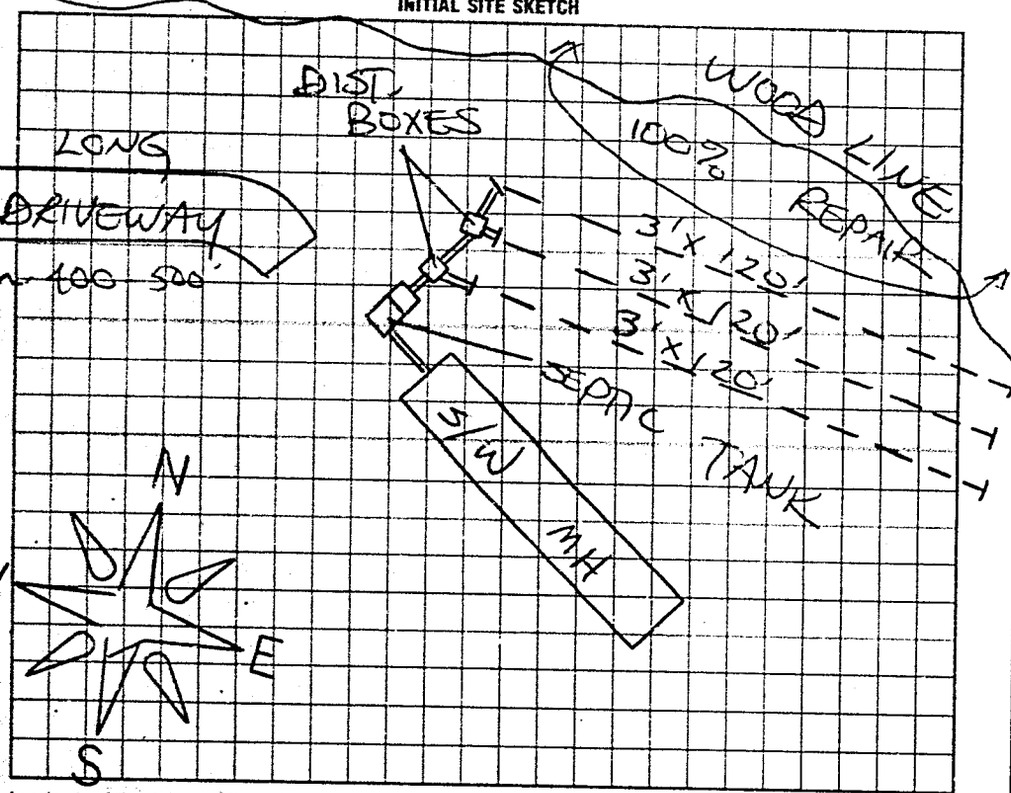

AS BUILT SKETCH

SYSTEM INSTALLED ACCORDING TO INITIAL SITE SKETCH

I understand that this permit can be suspended or revoked if any false information is supplied toward securing the permit/any unauthorized changes are made to the site/any unauthorized changes are made in the installation of the system. Improvement Permit is valid for 60 months from date of issuance.

Signed: X Tim Braddock

Improvement Permit by: STEVE HEARICK date 7/18/94

Existing System Inspection by: date

Installed by: HOWARD SLOAN / TIM BRADDOCK

Certificate of Completion by: STEVE HEARICK date 8/4/94

Operation Permit by: date

HEALTH DEPT. COPY: WHITE INSPECTION COPY (FINAL): GREEN OWNER COPY (FINAL): YELLOW INSPECTION COPY (INITIAL): PINK OWNER COPY (INITIAL): GOLD